

Union
 B 2004
 8/27/76

MISSISSIPPI
 BOARD OF WATER COMMISSIONERS
 416 North State Street
 Jackson, Mississippi 39201

WATER WELL DRILLERS LOG

UNION

8/27/76 MEDLIN WELLDRILLING ~~JOE COOK~~
 date well completed firm name county well located

Need Section

LANDOWNER: JOE COOK
NEW ALBANY MISS
 (mailing address)

description of formations encountered	from to	
Clay	0	40
Blue Mud	40	235
Sand & Rock	235	280

WELL LOCATION:
 sec. 6 T 6 N R. 2 E
84 miles WEST of NEW ALBANY
 (distance) (direction) (nearest town)

WELL PURPOSE: Home
 (home, irrigation, municipal, industrial)

- WELL COMPLETION DATA:
- (1) diameter (inches) 280
 - (2) total depth (feet) _____
 - (3) static water level (feet) 100 ^(below) above top of ground.
 - (4) casing Plastic 115
 (material) (depth)
 (size) if telescope see back.
 - (5) screen Ø (length) (depth to top)
 (size) (material)
 - (6) pump 2HP Ø
 (HP) (yield gpm)
 (type power)
 - (7) electric log (yes or no) _____
 (organization running log) _____
 - (8) how well bottom plugged _____


RECEIVED

DEC 2 1976

DRILLERS REMARKS:

If well telescopes please sketch and show depths.

GROUND LEVEL

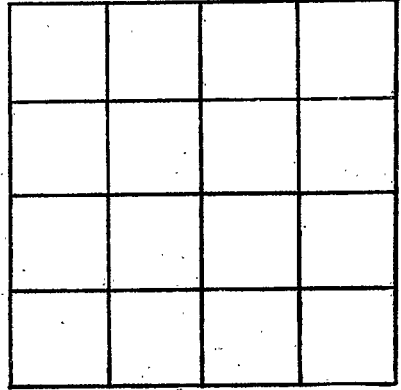

SECTION _____

Please indicate well location X.

ADDITIONAL INFORMATION

If more than one screen,
show locations of each on sketch.