

UNION
B 2000
7-23-77

MISSISSIPPI
BOARD OF WATER COMMISSIONERS
416 North State Street
15F Jackson, Mississippi 39201

WATER WELL DRILLERS LOG

07-23 1977 Medlin Well Drilling Union
date well completed firm name county well located

LANDOWNER: Len. G. CD/Thorp
Myrtle Miss
(mailing address)

description of formations encountered	from	to
<u>Olson</u>	<u>0</u>	<u>50</u>
<u>Blue Clay</u>	<u>50</u>	<u>170</u>
<u>Sand & Clay</u>	<u>170</u>	<u>250</u>

WELL LOCATION:
sec. 2 T. 6 N. R. 20 E.
5 1/2 miles West of North
(distance) (direction) (nearest town)

WELL PURPOSE:
(home, irrigation, municipal, industrial)

WELL COMPLETION DATA:

(1) diameter (inches) 4

(2) total depth (feet) 250

(3) static water level (feet) 80 below top of ground 170 above

(4) casing 150 130
(material) (depth)

(size) If telescope see back.

(5) screen (length) (depth to top)

(size) (material)

(6) pump 1/2 sub 9
(HP) (yield gpm)

(type power)

(7) electric log (yes or no)

(organization running log)

(8) how well bottom plugged OPEN


RECEIVED

SEP 26 1977

DRILLERS REMARKS:

If well telescopes please sketch and show depths.

GROUND LEVEL

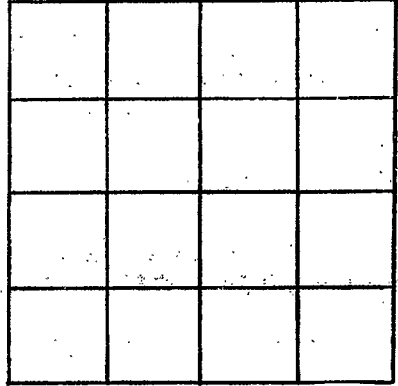

SECTION _____

Please indicate well location X.

ADDITIONAL INFORMATION

If more than one screen, show locations of each on sketch.