

Union
B 2001
8/3/77

MISSISSIPPI
BOARD OF WATER COMMISSIONERS
416 North State Street
15F Jackson, Mississippi 39201

WATER WELL DRILLERS LOG

8/3 - 1977 MEDLIN WELL DRIVING UNION
date well completed firm name county well located

LANDOWNER: GLEN WILLIAMS	description of formations encountered	from	to
NEW ALBANY	Mixed Clay	0	50
(mailing address)	Blue Clay	50	60
	Sand & Rock	160	230

WELL LOCATION:
sec. 2 T 6 N R 2 E
6 miles West of New Albany
(distance) (direction) (nearest town)

WELL PURPOSE:
(home, irrigation, municipal, industrial)

- WELL COMPLETION DATA:
- (1) diameter (inches) 7/8
 - (2) total depth (feet) 230
 - (3) static water level (feet) 50 below top of ground
 - (4) casing PIA 100 (material) (depth)
 - (size) if telescope see back.
 - (5) screen (length) (depth to top)
 - (size) (material)
 - (6) pump 1/2 Sub 10 (HP) (yield gpm)
 - (type power)
 - (7) electric log (yes or no)
 - (organization running log)
 - (8) how well bottom plugged OPEN


RECEIVED
SEP 30 1977

DRILLERS REMARKS:

MISS. Bd. OF WATER COMM.

If well telescopes please
sketch and show depths.

GROUND LEVEL

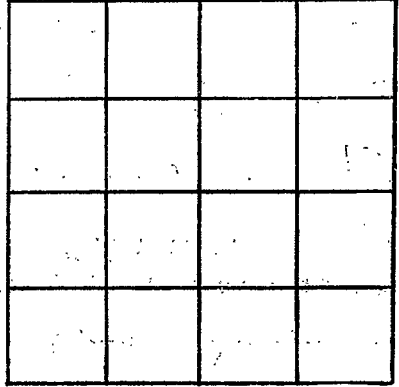

SECTION _____

Please indicate well location X.

ADDITIONAL INFORMATION

If more than one screen,
show locations of each on sketch.