

MISSISSIPPI
BOARD OF WATER COMMISSIONERS
416 North State Street
Jackson, Mississippi 39201

~~XXXXXXXXXX~~
UNION
B 2008
8-27-77
8-27
date well completed

WATER WELL DRILLERS LOG


15F 57 Mellin Well Drilling Union
firm name county well located

LANDOWNER:	description of formations encountered	from	to
<u>David Coltharp</u> <u>Mittle Miss.</u> (mailing address)	<u>Clay</u> <u>Blue clay</u> <u>Sand & Rock</u>	<u>0</u> <u>50</u> <u>50</u> <u>160</u>	<u>50</u> <u>165</u> <u>230</u>
WELL LOCATION: sec <u>2</u> T <u>6</u> N R <u>2</u> E <u>5</u> miles <u>West</u> of <u>New Albany</u> (distance) (direction) (nearest town)			
WELL PURPOSE: (home, irrigation, municipal, industrial)			
WELL COMPLETION DATA:			
(1) diameter (inches) <u>4</u>			
(2) total depth (feet) <u>230</u>			
(3) static water level (feet) <u>70</u> <u>below</u> top of ground.			
(4) casing <u>Pvc</u> <u>130</u> (material) (depth)			
(size) If telescope see back.			
(5) screen (length) (depth to top)			
(size) (material)			
(6) pump <u>2 hp</u> <u>12</u> (HP) (yield gpm)			
(type power)			
(7) electric log (yes or no)			
(organization running log)			
(8) how well bottom plugged <u>Open</u>			
DRILLERS REMARKS:			

RECEIVED
SEP 30 1977

If well telescopes please sketch and show depths.

GROUND LEVEL

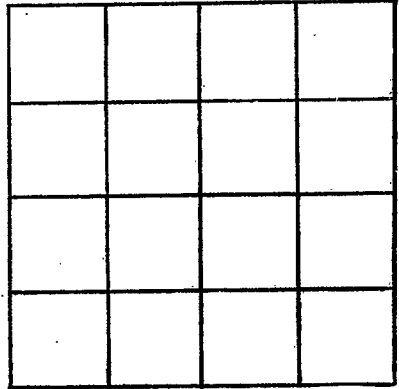

SECTION _____

Please indicate well location X.

ADDITIONAL INFORMATION

If more than one screen, show locations of each on sketch.