

UNION
B 2009

**MISSISSIPPI
BOARD OF WATER COMMISSIONERS**
416 North State Street
Jackson, Mississippi 39201

WATER WELL DRILLERS LOG

5-8-78 19 Bygones Well Drilling Union
 date well completed firm name county well located

LANDOWNER:	description of formations encountered	from	to
<u>Billy Joe Peltier</u>			
<u>New Albany Miss</u> (mailing address)	<u>Mixed Clay</u>	<u>0</u>	<u>40</u>
	<u>Blue Clay</u>	<u>40</u>	<u>230</u>
	<u>Sand & Rock</u>	<u>230</u>	<u>300</u>

WELL LOCATION:
 sec. 2 T12 N R 2 E
4? miles West of New Albany
 (distance) (direction) (nearest town)

WELL PURPOSE: Hand
 (home, irrigation, municipal, industrial)


- WELL COMPLETION DATA:**
- (1) diameter (inches) 4
 - (2) total depth (feet) 300
 - (3) static water level (feet) 80 below above top of ground.
 - (4) casing Pbs. 135
 (material) (depth)
 (size) if telescope see back.
 - (5) screen _____
 (length) (depth to top)
 (size) (material)
 - (6) pump 1/2 8
 (HP) (yield gpm)
Elec
 (type power)
 - (7) electric log _____
 (yes or no)
 (organization running log)
 - (8) how well bottom plugged Open

DRILLERS REMARKS:

RECEIVED
AUG - 3 1978
 MISS. BD. OF WATER COMMISSIONERS

If well telescopes please
sketch and show depths.

GROUND LEVEL

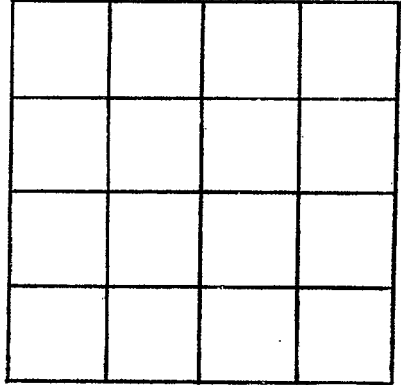

SECTION _____

Please indicate well location X.

ADDITIONAL INFORMATION

If more than one screen,
show locations of each on sketch.