

MISSISSIPPI DEPARTMENT OF NATURAL RESOURCES

Bureau of Land and Water Resources

Southport Mall

P.O. Box 10631

Jackson, Mississippi 39209

WATER WELL DRILLERS LOG

Union
Board

3-17 1982
date well completed

J. W. Webb
firm name

UNION
county well located

LANDOWNER:	description of formations encountered	from	to
<u>A. J. Gladney</u>			
<u>MYRTLE MISS</u> (mailing address)	<u>FAN SILT</u>	<u>5</u>	<u>20</u>
WELL LOCATION:	<u>FAN SAND</u>	<u>20</u>	<u>40</u>
sec. <u>17</u> T <u>6</u> N R <u>20</u> E	<u>Blue CLAY</u>	<u>40</u>	<u>290</u>
(distance) miles (direction) of <u>MYRTLE</u>	<u>BREY SAND & Shell</u>	<u>290</u>	<u>340</u>
(nearest town)	<u>BREY SANDSTONE</u>	<u>340</u>	<u>350</u>
WELL PURPOSE:	<u>SANDY CLAY</u>	<u>350</u>	<u>390</u>
(home, irrigation, municipal, industrial)	<u>BREY SAND</u>	<u>390</u>	<u>440</u>
WELL COMPLETION DATA:			
(1) diameter (inches) <u>4"</u>			
(2) total depth (feet) <u>440'</u>			
(3) static water level (feet) <u>140</u> <u>below</u> top of ground.			
(4) casing <u>Steel</u> , <u>84'</u> (material), (depth)			
(size) if telescope see back.			
(5) screen (length) (depth to top)			
(size) (material)			
(6) pump <u>3/4</u> (HP) <u>9</u> (yield gpm)			
<u>Etc</u> (type power)			
(7) electric log (yes or no)			
(organization running log)			
(8) how well bottom plugged			
DRILLERS REMARKS:			


DEPT. OF NATURAL RESOURCES
BUREAU OF LAND & WATER RESOURCES

APR 19 1982

RECEIVED

If well telescopes please sketch and show depths.

GROUND LEVEL

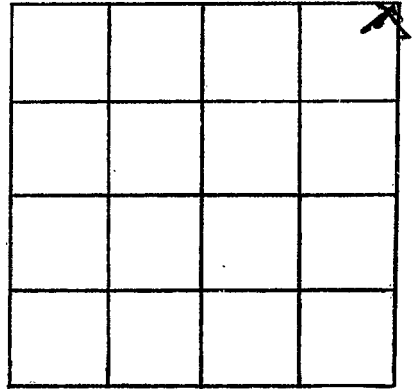

SECTION 17

Please indicate well location X.

ADDITIONAL INFORMATION

If more than one screen,
show locations of each on sketch.