

MISSISSIPPI DEPARTMENT OF NATURAL RESOURCES

Bureau of Land and Water Resources

Southport Mall

P.O. Box 10631

Jackson, Mississippi 39209

WATER WELL DRILLERS LOG

Union
B 2012

8-19- 1982 J.T. Medlin UNION
date well completed firm name county well located

LANDOWNER:
Darrell - Lowell
Road 1 Myrtle MS.
(mailing address)

description of formations encountered	from	to
	<u>Clay - Rock</u>	<u>0</u>
<u>Quartzite</u>	<u>100</u>	<u>240</u>
<u>quartz sand</u>	<u>240</u>	<u>300</u>

WELL LOCATION:
sec. 8 T. 6 N. R. 2 E.
2 miles W of Myrtle
(distance) (direction) (nearest town)

WELL PURPOSE:
(home, irrigation, municipal, industrial)

WELL COMPLETION DATA:

(1) diameter (inches) 4

(2) total depth (feet) 300

(3) static water level (feet) 120 below above top of ground.

(4) casing Pvc 180
(material) (depth)

 if telescope see back.
(size)

(5) screen
(length) (depth to top)

(size) (material)

(6) pump 12 10
(HP) (yield gpm)

Ele
(type power)

(7) electric log
(yes or no)

(organization running log)

(8) how well bottom plugged

DRILLERS REMARKS:


DEPT. OF NATURAL RESOURCES
BUREAU OF LAND & WATER RESOURCES

SEP 22 1982

RECEIVED

If well telescopes please sketch and show depths.

GROUND LEVEL

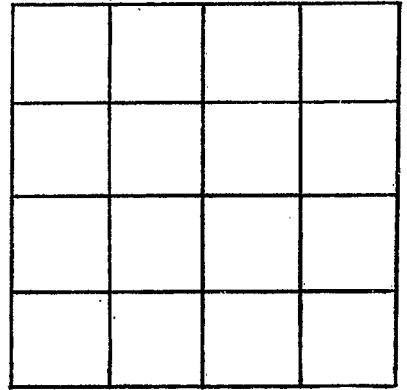

SECTION _____

Please indicate well location X.

ADDITIONAL INFORMATION

If more than one screen,
show locations of each on sketch.