

MISSISSIPPI DEPARTMENT OF NATURAL RESOURCES

Bureau of Land and Water Resources

Southport Mall

P.O. Box 10631

Jackson, Mississippi 39209

WATER WELL DRILLERS LOG

Union  
B 2013

6

8-25-1982  
date well completed

J.T. Medlin  
firm name

UNION  
county well located

| LANDOWNER:                                                                                                                              | description of formations encountered | from | to  |
|-----------------------------------------------------------------------------------------------------------------------------------------|---------------------------------------|------|-----|
| Gerdine Stenson<br>myrtle ms.<br>(mailing address)                                                                                      |                                       |      |     |
| WELL LOCATION:<br>sec. <u>3</u> T. <u>6</u> N. R. <u>2</u> E<br><u>4</u> miles N. E. of Myrtle<br>(distance) (direction) (nearest town) | Clay                                  | 60   | 280 |
| WELL PURPOSE:<br>(home, irrigation, municipal, industrial)                                                                              | Shale - Rock                          | 280  | 380 |
| WELL COMPLETION DATA:                                                                                                                   |                                       |      |     |
| (1) diameter (inches) <u>4</u>                                                                                                          |                                       |      |     |
| (2) total depth (feet) <u>380</u>                                                                                                       |                                       |      |     |
| (3) static water level (feet) <u>80</u> below<br>top of ground.                                                                         |                                       |      |     |
| (4) casing <u>Pvc</u> <u>100</u><br>(material) (depth)                                                                                  |                                       |      |     |
| <u>        </u> if telescope see back.<br>(size)                                                                                        |                                       |      |     |
| (5) screen <u>        </u> <u>        </u><br>(length) (depth to top)                                                                   |                                       |      |     |
| <u>        </u> (size) <u>        </u> (material)                                                                                       |                                       |      |     |
| (6) pump <u>1/2</u> <u>10</u><br>(HP) (yield gpm)                                                                                       |                                       |      |     |
| <u>EIE</u><br>(type power)                                                                                                              |                                       |      |     |
| (7) electric log <u>        </u><br>(yes or no)                                                                                         |                                       |      |     |
| <u>        </u><br>(organization running log)                                                                                           |                                       |      |     |
| (8) how well bottom plugged <u>        </u>                                                                                             |                                       |      |     |
| DRILLERS REMARKS:                                                                                                                       |                                       |      |     |


DEPT. OF NATURAL RESOURCES  
BUREAU OF LAND & WATER RESOURCES

NOV 22 1982

RECEIVED

If well telescopes please sketch and show depths.

GROUND LEVEL

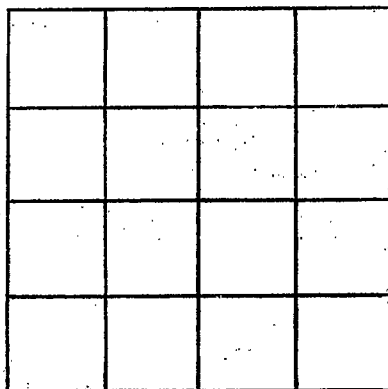

SECTION \_\_\_\_\_

Please indicate well location X.

ADDITIONAL INFORMATION

If more than one screen,  
show locations of each on sketch.