

MISSISSIPPI DEPARTMENT OF NATURAL RESOURCES

Bureau of Land and Water Resources

Southport Mall

P.O. Box 10631

Jackson, Mississippi 39209

WATER WELL DRILLERS LOG

Union  
B 2014

8/27/82 19\_\_  
date well completed

LEEPER Drilling  
firm name

Union  
county well located

LANDOWNER: Jerry Green  
Myrtle, Ms.  
(mailing address)

description of formations encountered	from	to
<u>TOP CLAY</u>	<u>0</u>	<u>15</u>
<u>Blue clay</u>	<u>15</u>	<u>200</u>
<u>Chalk</u>	<u>200</u>	<u>380</u>
<u>SAND</u>	<u>380</u>	<u>420</u>

WELL LOCATION:  
sec. 29 T 6 N R 2 E  
S  
2 miles S of Myrtle  
(distance) (direction) (nearest town)

WELL PURPOSE: HOME  
(home, irrigation, municipal, industrial)

- WELL COMPLETION DATA:
- (1) diameter (inches) 4"
  - (2) total depth (feet) 420'
  - (3) static water level (feet) 120 <sup>below</sup> above top of ground.
  - (4) casing PVC, 160'  
(material) (depth)  
4" (size) if telescope see back.
  - (5) screen None  
(length) (depth to top)  
(size) (material)
  - (6) pump 3/4 10  
(HP) (yield gpm)  
electric  
(type power)
  - (7) electric log NO  
(yes or no)  
(organization running log)
  - (8) how well bottom plugged OPEN

DRILLERS REMARKS:


DEPT. OF NATURAL RESOURCES  
BUREAU OF LAND & WATER RESOURCES

DEC - 6 1982

RECEIVED

If well telescopes please sketch and show depths.

GROUND LEVEL

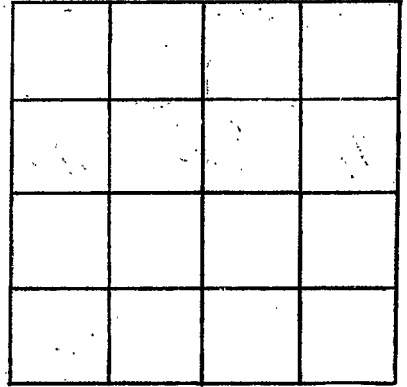

SECTION \_\_\_\_\_

Please indicate well location X.

ADDITIONAL INFORMATION

If more than one screen,  
show locations of each on sketch.