

MISSISSIPPI DEPARTMENT OF NATURAL RESOURCES

Bureau of Land and Water Resources

Southport Mall

P.O. Box 10631

Jackson, Mississippi 39209

WATER WELL DRILLERS LOG

Union
B 2015
4-22-83

83

19 4-22 Medlin UNION

date well completed

firm name

county well located

LANDOWNER:

WYNONA Crockrell

Myrtle Ms.

(mailing address)

description of formations encountered

from

to

clay

0-120

WELL LOCATION:

sec. 11 T. 6 N. R. 2 E.

3 miles

(distance)

(direction)

of Myrtle (nearest town)

clay - limestone 120-260

limestone

260-300

WELL PURPOSE:

(home, irrigation, municipal, industrial)

agricultural

300-300

WELL COMPLETION DATA:

(1) diameter (inches) 4

(2) total depth (feet) 260

(3) static water level (feet) 80 below top of ground.

(4) casing PVC (material) 180 (depth)

_____ if telescope see back. (size)

(5) screen _____ (length) _____ (depth to top)

_____ (size) _____ (material)

(6) pump 1/2 (HP) 10 (yield gpm)

EIE (type power)

(7) electric log _____ (yes or no)

_____ (organization running log)


(8) how well bottom plugged Open

DRILLERS REMARKS:

lot of clay

If well telescopes please sketch and show depths.

GROUND LEVEL

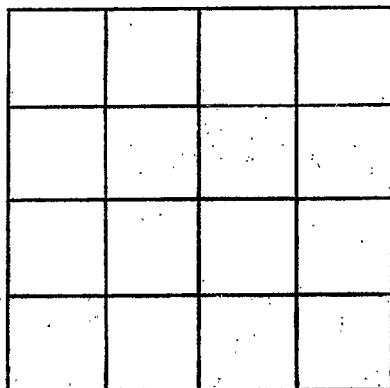

SECTION _____

Please indicate well location X.

ADDITIONAL INFORMATION

If more than one screen,
show locations of each on sketch.