

Union  
Bank

MISSISSIPPI DEPARTMENT OF NATURAL RESOURCES

Bureau of Land and Water Resources

Southport Mall

P.O. Box 10631

Jackson, Mississippi 39209

WATER WELL DRILLERS LOG

3-7-1983 date well completed      Leeper Drilling Union firm name      county well located

LANDOWNER: Kenneth Wilson

Rt 1 (Covingtonville Community)

Myrtle Ms  
(mailing address)

description of formations encountered	from	to
<u>Top Clay</u>	<u>0</u>	<u>20</u>
<u>Blue Clay</u>	<u>20</u>	<u>400</u>
<u>Chalk</u>	<u>140</u>	<u>510</u>
<u>Sand</u>	<u>510</u>	<u>565</u>

WELL LOCATION:

sec. 30 T 6 N R 2 E  
3 miles SW of Myrtle  
 (distance) (direction) (nearest town)

WELL PURPOSE: For  
 (home, irrigation, municipal, industrial)

WELL COMPLETION DATA:

- (1) diameter (inches) 4"
- (2) total depth (feet) 565
- (3) static water level (feet) 20 below above top of ground
- (4) casing WC 140  
 (material) (depth)  
4" if telescope see back.  
 (size)
- (5) screen None  
 (length) (depth to top)  
 (size) (material)
- (6) pump 3/4 12  
 (HP) (yield gpm)  
electric  
 (type power)
- (7) electric log NO  
 (yes or no)

(organization running log)

(8) how well bottom plugged OPEN

DRILLERS REMARKS:


DEPT. OF NATURAL RESOURCES  
 BUREAU OF LAND & WATER RESOURCES

MAY 31 1984

RECEIVED

If well telescopes please sketch and show depths.

GROUND LEVEL

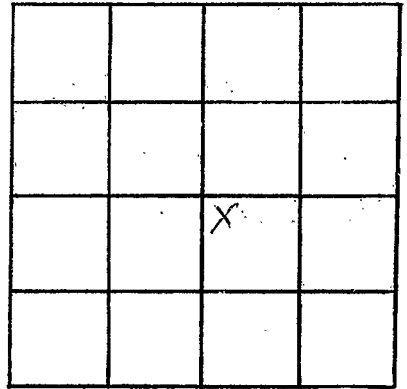

SECTION 30

Please indicate well location X.

ADDITIONAL INFORMATION

If more than one screen,  
show locations of each on sketch.