

Union
B 2018

MISSISSIPPI DEPARTMENT OF NATURAL RESOURCES
Bureau of Land and Water Resources
Southport Mall
P.O. Box 10631
Jackson, Mississippi 39209
WATER WELL DRILLERS LOG


1-2-26 1984 Medline Union
date well completed firm name county well located

LANDOWNER:	description of formations encountered	from	to
<u>Jerry Cleveland</u> <u>Myrtle</u> (mailing address)			
WELL LOCATION: sec. <u>32</u> T <u>76</u> R <u>1</u> E <u>3</u> miles <u>South</u> of <u>Myrtle</u> (distance) (direction) (nearest town)	<u>Clay + rock</u>	<u>180</u>	<u>320</u>
WELL PURPOSE: <input checked="" type="checkbox"/> (home) Irrigation, municipal, industrial	<u>Limestone</u>	<u>320</u>	<u>480</u>
WELL COMPLETION DATA: (1) diameter (inches) <u>4"</u>	<u>Aquifer</u>	<u>480</u>	<u>520</u>
(2) total depth (feet) <u>520'</u>			
(3) static water level (feet) <u>200'</u> below top of ground.			
(4) casing <u>PVC</u> <u>360'</u> (material) (depth)			
_____ if telescope see back. (size)			
(5) screen _____ (length) (depth to top)			
_____ (size) _____ (material)			
(6) pump <u>11</u> <u>110</u> (HP) (yield gpm)			
<u>Elox.</u> (type power)			
(7) electric log _____ (yes or no)			
_____ (organization running log)			
(8) how well bottom plugged _____			
DRILLERS REMARKS:			

DEPT. OF NATURAL RESOURCES
BUREAU OF LAND & WATER RESOURCES
SEP 17 1984
RECEIVED

If well telescopes please sketch and show depths.

GROUND LEVEL

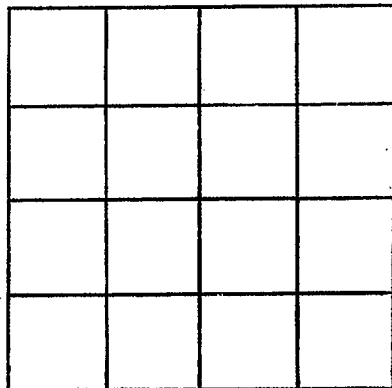

SECTION _____

Please indicate well location X.

ADDITIONAL INFORMATION

If more than one screen, show locations of each on sketch.