

MISSISSIPPI DEPARTMENT OF NATURAL RESOURCES

Bureau of Land and Water Resources

Southport Mall

P.O. Box 10631

Jackson, Mississippi 39209

WATER WELL DRILLERS LOG

Union
B 209

10-14-84

date well completed

Medlin Water Well

firm name

Union Benton

county well located

LANDOWNER:
Linda Foley
Hickory Flat, MS.
(mailing address) on P.C.
between Hwy 5 & 78


description of formations encountered	from	to
Rock & Top soil	0	80
Rock	80	180
Rock & Limestone	180	420
Rock	420	500
Water & Sand	500	680
Aquifer	680	780

WELL LOCATION:
sec 5 T 6 N R 10 E
3 miles N/W of Hickory Flat
(distance) (direction) (nearest town)

WELL PURPOSE:
(Home, Irrigation, municipal, industrial)


- WELL COMPLETION DATA:
- diameter (inches) 4"
 - total depth (feet) 780'
 - static water level (feet) 280' below top of ground
 - casing PVC, 570' (material) (depth)
(size) if telescope see back.
 - screen (length) (depth to top)
(size) (material)
 - pump 1 (HP) 8 (yield gpm)
(type power)
 - electric log (yes or no)
(organization running log)
 - how well bottom plugged

DRILLERS REMARKS:

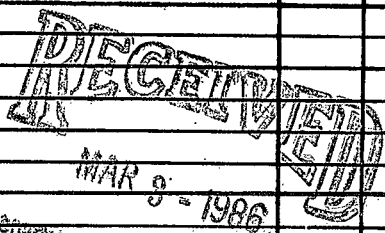

If well telescopes please
sketch and show depths.

GROUND LEVEL

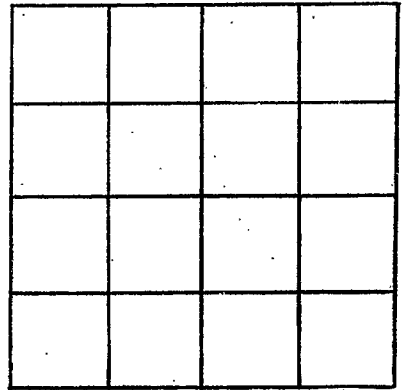

SECTION _____

Please indicate well location X.

ADDITIONAL INFORMATION

If more than one screen,
show locations of each on sketch.