

MISSISSIPPI DEPARTMENT OF NATURAL RESOURCES

Bureau of Land and Water Resources

Southport Mall

P.O. Box 10631

Jackson, Mississippi 39209

WATER WELL DRILLERS LOG

UNION
B 2023

12-6-86 19
date well completed

Medlin Well Drilling
firm name

Union
county well located

LANDOWNER:
Robert Evans
New Albany, MS.
(mailing address)

description of formations encountered	from	to
Top Soil	0-	90
Sand & Rock	90-	210
Sand & Aquifer	210-	320

WELL LOCATION:
sec. 2 T. 6 N. R. 2 E.
3 1/2 miles NW of New Albany
(distance) (direction) (nearest town)

WELL PURPOSE:
(home, irrigation, municipal, industrial)

- WELL COMPLETION DATA:
- (1) diameter (inches) 4"
 - (2) total depth (feet) 320'
 - (3) static water level (feet) 90' ^{below} top of ground.
 - (4) casing PVC, 180' (material) (depth)
(size) If telescope see back.
 - (5) screen (length) (depth to top)
(size) (material)
 - (6) pump 1/2 (HP) 14 (yield gpm)
Elec. (type power)
 - (7) electric log (yes or no)
(organization running log)
 - (8) how well bottom plugged

RECEIVED


DEC 15 1986

Department of Natural Resources
Bureau of Land & Water Resources

DRILLERS REMARKS:

If well telescopes please
sketch and show depths.

GROUND LEVEL

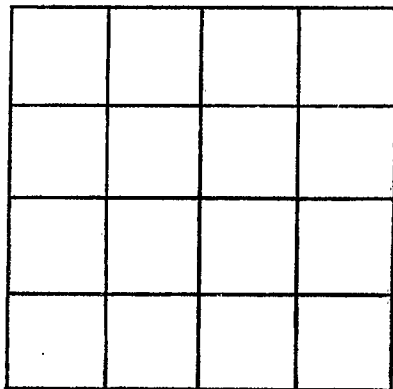

SECTION _____

Please indicate well location X.

ADDITIONAL INFORMATION

If more than one screen,
show locations of each on sketch.