

MISSISSIPPI DEPARTMENT OF NATURAL RESOURCES

Bureau of Land and Water Resources

Southport Mall

P.O. Box 10631

Jackson, Mississippi 39209

WATER WELL DRILLERS LOG

Union  
B 2024

5.21 1987 Medlin Well Drilling Union  
date well completed firm name county well located

LANDOWNER:  
Ralph Smithey  
Myrtle, MS.  
(mailing address)

description of formations encountered	from	to
Top Soil	0	70
Clay, Rock	70	180
Aquifer & Rock	180	300

WELL LOCATION:  
sec. 28 6 N R 2 E  
1 miles East of Myrtle  
(distance) (direction) (nearest town)

WELL PURPOSE:  
(home, irrigation, municipal, industrial)

WELL COMPLETION DATA:

(1) diameter (inches) 4

(2) total depth (feet) 320'

(3) static water level (feet) 100' below top of ground.

(4) casing PVC, 140' (material) (depth)  
(size) If telescope see back.

(5) screen (length) (depth to top)

(6) pump 1/2 (HP) 12 (material) (yield gpm)  
Elec. (type power)

(7) electric log (yes or no)  
(organization running log)


(8) how well bottom plugged

Department of Natural Resources
Bureau of Land & Water Resources
SEP 28 1987
RECEIVED

DRILLERS REMARKS:

If well telescopes please  
sketch and show depths.

GROUND LEVEL

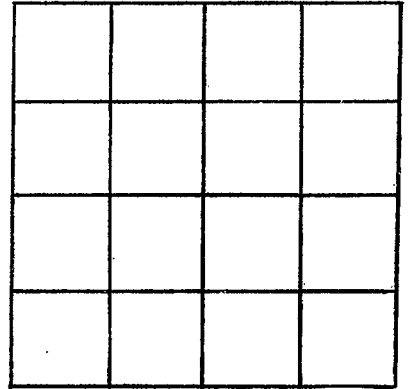

SECTION \_\_\_\_\_

Please indicate well location X.

ADDITIONAL INFORMATION

If more than one screen,  
show locations of each on sketch.