

MISSISSIPPI DEPARTMENT OF NATURAL RESOURCES

Bureau of Land and Water Resources

Southport Mall

P.O. Box 10631

Jackson, Mississippi 39209

WATER WELL DRILLERS LOG

UNION
B 2025

10-12-87  
date well completed

Medlin Well Drilling  
firm name

Union  
county well located

LANDOWNER:  
 Tim Longford  
 New Albany, Ms.  
 (mailing address)

description of formations encountered

from to

Top Soil

0 80

Rock & Sand

80-220

Aquifer

220 300

WELL LOCATION:

sec 22 T 6 N R 2 E  
 3 miles NW of N.A.  
 (distance) (direction) (nearest town)

WELL PURPOSE:

(home, irrigation, municipal, industrial)

WELL COMPLETION DATA:

- (1) diameter (inches) 4"
- (2) total depth (feet) 300'
- (3) static water level (feet) 90 <sup>below</sup> <sub>above</sub> top of ground.
- (4) casing PVC 180'  
 (material) (depth)  
 (size) if telescope see back.
- (5) screen \_\_\_\_\_  
 (length) (depth to top)  
 (size) (material)
- (6) pump 1/2 12  
 (HP) (yield gpm)  
Electric  
 (type power)
- (7) electric log \_\_\_\_\_  
 (yes or no)  
 (organization running log)
- (8) how well bottom plugged \_\_\_\_\_

RECEIVED


SEP 28 1989

Department of Natural Resources  
Bureau of Land & Water Resources

DRILLERS REMARKS:

If well telescopes please  
sketch and show depths.

GROUND LEVEL

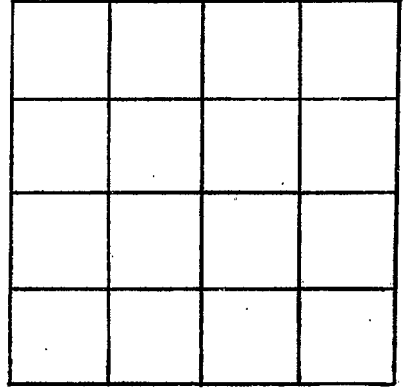

SECTION \_\_\_\_\_

Please indicate well location X.

ADDITIONAL INFORMATION

If more than one screen,  
show locations of each on sketch.