

MISSISSIPPI DEPARTMENT OF NATURAL RESOURCES

Bureau of Land and Water Resources

Southport Mall

P.O. Box 10631

Jackson, Mississippi 39209

WATER WELL DRILLERS LOG

Union
B B
2027

11.11 1987
date well completed

Medlin Well
firm name

Union
county well located

LANDOWNER:
Henry Potts
Poolerville, Ms.
(mailing address)

description of formations encountered	from	to
Spittle Sand & Clay	0	150
Rock & Aquifer	150	280

WELL LOCATION:
sec. 33 T 6 N R 20 E
2 miles East of Poolerville
(distance) (direction) (nearest town)

WELL PURPOSE:
(home, irrigation, municipal, industrial)

WELL COMPLETION DATA:

(1) diameter (inches) 4"

(2) total depth (feet) 280'

(3) static water level (feet) 120 ^{below}/_{above} top of ground.

(4) casing PVC 150'
(material) (depth)
(size) if telescope see back.

(5) screen _____
(length) (depth to top)
(size) (material)

(6) pump 1/2 8
(HP) (yield gpm)
Electric
(type power)

(7) electric log _____
(yes or no)
(organization running log)

(8) how well bottom plugged _____

RECEIVED


SEP 28 1989

Department of Natural Resources
Bureau of Land & Water Resources

DRILLERS REMARKS:

If well telescopes please sketch and show depths.

GROUND LEVEL

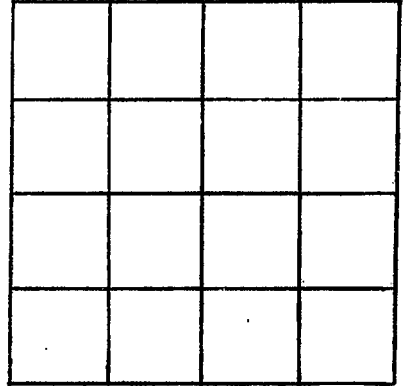

SECTION _____

Please indicate well location X.

ADDITIONAL INFORMATION

If more than one screen,
show locations of each on sketch.