

UNION
C8
4-14-71

MISSISSIPPI
BOARD OF WATER COMMISSIONERS
416 North State Street
Jackson, Mississippi 39201

CODED

WATER WELL DRILLERS LOG

4 14 19 71 JT Medlin Union
date well completed firm name county well located

LANDOWNER: Rosco Trozier

New Albany

(mailing address)

WELL LOCATION:

sec. 26 T 6 N R 3 E
4 miles N.E. of New Albany
(distance) (direction) (nearest town)

WELL PURPOSE:

(home, irrigation, municipal, industrial)

WELL COMPLETION DATA:

- (1) diameter (inches) 4
- (2) total depth (feet) 280
- (3) static water level (feet) 70 below top of ground.
- (4) casing P 140, (material) (depth)
(size) if telescope see back.
- (5) screen (length) (depth to top)
(size) (material)
- (6) pump 3/4 4 (HP) (yield gpm)
E (type power)
- (7) electric log (yes or no)
(organization running log)
- (8) how well bottom plugged BW

description of formations encountered

from to

Clay	0	16
Rock & Clay	16	28
Blue Clay & Rock	28	70
Sand	70	76
Rock	76	88
Sand	88	137
Blue	137	155
Sand	155	161
Blue	161	216
Sand	216	226
Blue	226	260
Sand	260	280

CODED


MAY 4 1971

MISS. BD. OF
WATER COMM.

DRILLERS REMARKS:

If well telescopes please
sketch and show depths.

GROUND LEVEL

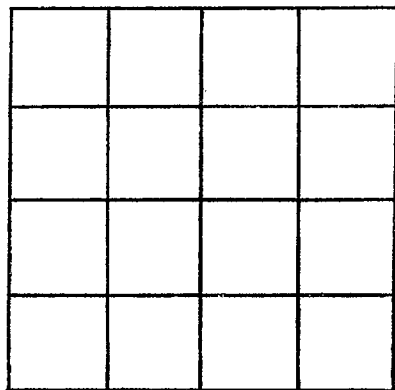

SECTION _____

Please indicate well location X.

ADDITIONAL INFORMATION

If more than one screen,
show locations of each on sketch.