

Union  
C13  
1-17-69

MISSISSIPPI  
BOARD OF WATER COMMISSIONERS  
416 North State Street  
Jackson, Mississippi 39201

CODED  
CODED

WATER WELL DRILLERS LOG

1-17-69 1969 date well completed  
J. W. Webb & Sons Inc firm name  
Union county well located

LANDOWNER: Gray Akers

description of formations encountered

from to

new albany  
(mailing address)

soil	0	15
clay & sand	15	73
Blue Marl	73	90
Sand	90	140
Blue Rock	140	180
Water Sand	180	220

WELL LOCATION:

sec. 12 T. 6 S. R. 3 E  
4 miles north of New Albany  
(distance) (direction) (nearest town)

WELL PURPOSE: home  
(home, irrigation, municipal, industrial)

WELL COMPLETION DATA:

- (1) diameter (inches) 4
- (2) total depth (feet) 220
- (3) static water level (feet) 60 below top of ground.
- (4) casing steel, 8 ft (material), (depth)
- (size) if telescope see back.
- (5) screen 0 (length), (depth to top)
- (size) (material)
- (6) pump jet 4 (HP), (yield gpm)
- 6 hp (type power)
- (7) electric log no (yes or no)
- (organization running log)
- (8) how well bottom plugged open

CODED

CODED


DRILLERS REMARKS:

JAN 29 1969

MISS. BD. OF  
WATER COMMISSIONERS

If well telescopes please sketch and show depths.

GROUND LEVEL

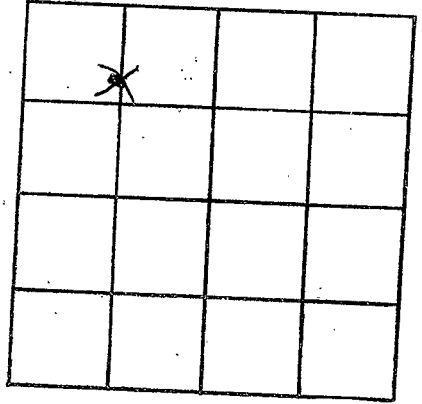

SECTION 12

Please indicate well location X.

ADDITIONAL INFORMATION

If more than one screen,  
show locations of each on sketch.