

MISSISSIPPI
BOARD OF WATER COMMISSIONERS
416 North State Street
Jackson, Mississippi 39201

CODED

WATER WELL DRILLERS LOG

Union
C 15
6-20-69
M.G.S.

June 20, 1969 J.W. Webb & Sons UNION
date well completed firm name county well located

LANDOWNER:

NORTH HAVEN WTR. DIST.
NEW ALBANY, MISS.
(mailing address)

WELL LOCATION:

sec 16 T 6 N R 30 E
3 miles N of New Albany
(distance) (direction) (nearest town)

WELL PURPOSE: COMMUNITY
(home, irrigation, municipal, industrial)

WELL COMPLETION DATA:

- (1) diameter (inches) 8
- (2) total depth (feet) 856
- (3) static water level (feet) 178 below top of ground.
- (4) casing Steel 760 (material) (depth)
8" (size) if telescope see back.
- (5) screen 80 640 (length) (depth to top)
4" STAINLESS Steel (size) (material)
- (6) pump 25 150 (HP) (yield-gpm)
ELEC (type power)
- (7) electric log Yes (yes or no)
STATE GEOLOGICAL (organization running log)
- (8) how well bottom plugged WASH PING

description of formations encountered

description of formations encountered	from	to
Red SAND & Clay	0	35
Grey SAND	35	330
Blue MARL	330	620
SAND & Shell	620	645
Blue MARL	645	670
Blue Grey SAND	670	750
Blue MARL	750	770
Blue SAND	770	1050
ROCK	1050	1080

CODED

OCT 16 1969

MISS. Bd. OF WATER COMM.

DRILLERS REMARKS: 1

(X)

If well telescopes please sketch and show depths.

GROUND LEVEL

8" CRDIN

640

760


GRAVEL PACK

4" SCREEN

836

76

28" under beam

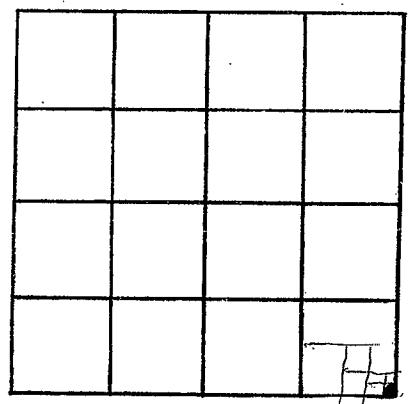

SECTION _____

Please indicate well location X.

ADDITIONAL INFORMATION

SCREEN FROM 776-856

If more than one screen, show locations of each on sketch.