

CODED

MISSISSIPPI  
BOARD OF WATER COMMISSIONERS  
416 North State Street  
Jackson, Mississippi 39201

CODED

WATER WELL DRILLERS LOG

Union
C 16
7-3-69

July 8 1969 J T Medlin Union  
 date well completed firm name county well located

LANDOWNER: Salvador Thompson  
New Albany  
Miss  
 (mailing address)

description of formations encountered	from	to
	Red Clay	0
Yellow Clay + Rock	16	53
Red Sand	53	65
Rock	65	76
Blue Clay	76	119
Sand & Rock	119	185

WELL LOCATION:  
 sec. 7 T. 2 N. R. 3 E.  
2 miles S of Hill Beacon  
 (distance) (direction) (nearest town)

WELL PURPOSE:  
 (home, irrigation, municipal, industrial)

WELL COMPLETION DATA: July 5 1969

- (1) diameter (inches) 4
- (2) total depth (feet) 185
- (3) static water level (feet) 120 below above top of ground.
- (4) casing P 185  
 (material) (depth)  
4 if telescope see back.  
 (size)
- (5) screen 40 125  
 (length) (depth to top)  
4 P  
 (size) (material)
- (6) pump 1 6  
 (HP) (yield gpm)  
E  
 (type power)
- (7) electric log yes or no

CODED

(organization running log)

(8) how well bottom plugged


DRILLERS REMARKS:

JUL 31 1969

MISS. RD. OF  
WATER COMM.

If well telescopes please sketch and show depths.

GROUND LEVEL

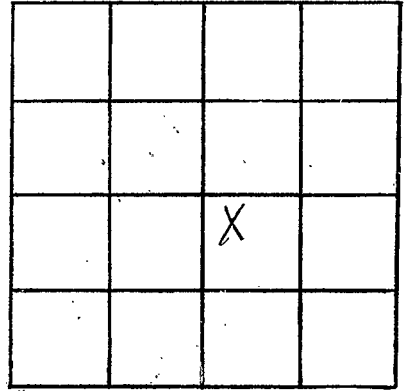

SECTION \_\_\_\_\_

Please indicate well location X.

ADDITIONAL INFORMATION

If more than one screen,  
show locations of each on sketch.