

Union
 C17
 7-5-69

MISSISSIPPI
 BOARD OF WATER COMMISSIONERS
 416 North State Street
 Jackson, Mississippi 39201

COPIED

WATER WELL DRILLERS LOG

7-5-1969 date well completed
 Jung & Abel Co. firm name
 Union county well located

LANDOWNER:

Gray Sorden
 New Albany, Miss 38652
 (mailing address)

description of formations encountered

from to

mixed clay 0 30
 Clay 30 100
 Sand & Rock 100 180

WELL LOCATION:

sec 29 T 6 R 3 E
 S 3 miles SW. of New Albany
 (distance) (direction) (nearest town)

WELL PURPOSE:

Home (home, irrigation, municipal, industrial)

WELL COMPLETION DATA:

- (1) diameter (inches) 4 80
- (2) total depth (feet) 180
- (3) static water level (feet) 40 below top of ground.
- (4) casing PVC 80 (material), (depth)
- (size) if telescope see back.
- (5) screen 0 (length), 0 (depth to top)
- (size) (material)
- (6) pump 1/2 HP 8 (HP) (yield gpm)
- Evee (type power)
- (7) electric log 0 (yes or no)
- (organization running log)
- (8) how well bottom plugged 0


DRILLERS REMARKS:

FEB 18 1970

MISS. BD. OF WATER COMMISSIONERS

If well telescopes please sketch and show depths.

GROUND LEVEL

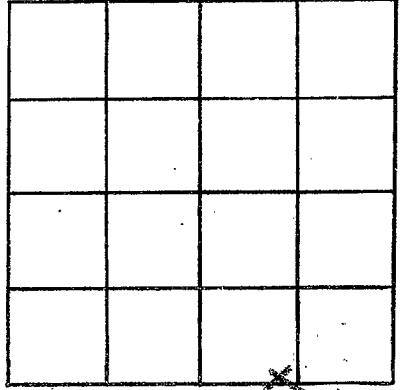

SECTION 29

Please indicate well location X.

ADDITIONAL INFORMATION

If more than one screen, show locations of each on sketch.