

Union
C 19
5-12-70

MISSISSIPPI
BOARD OF WATER COMMISSIONERS
416 North State Street
Jackson, Mississippi 39201

CODED

WATER WELL DRILLERS LOG

5 12 1970 J T Medlin Union
date well completed firm name county well located

LANDOWNER: J. SMITH
New Albany
(mailing address) 216

description of formations encountered	from	to
Clay	0	13
SAND	13	32
ROCK	32	45
Clay	45	115
Yellow sand	115	121
Blue Clay	121	165
SAND	165	185
Blue Clay	185	208
SAND	208	219
Blue Clay	219	237

WELL LOCATION:
sec. 23 T. 6 N. R. 3 E
3 miles NE of NEW ALBANY
(distance) (direction) (nearest town)

WELL PURPOSE:
(home, irrigation, municipal, industrial)

WELL COMPLETION DATA:

- (1) diameter (inches) 4
- (2) total depth (feet) 232
- (3) static water level (feet) 73 below top of ground.
- (4) casing P 140 (material) (depth)
(size) if telescope see back.
- (5) screen (length) (depth to top)
(size) (material)
- (6) pump 7 6 (HP) (yield gpm)
E (type power)
- (7) electric log (yes or no)
(organization running log)
- (8) how well bottom plugged


CODED

JUN 3 1970
MISS. BD. OF
WATER COMM.

DRILLERS REMARKS:

If well telescopes please sketch and show depths.

GROUND LEVEL

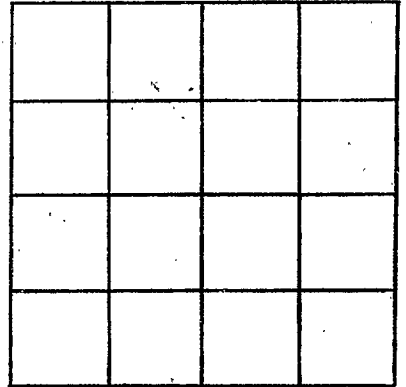

SECTION _____

Please indicate well location X.

ADDITIONAL INFORMATION

If more than one screen, show locations of each on sketch.