

**CODED**

MISSISSIPPI  
BOARD OF WATER COMMISSIONERS

416 North State Street *Box 7-3670*

Jackson, Mississippi 39201

*Recd 7/20/70*

WATER WELL DRILLERS LOG

*Union*  
*C 21*  
*6-27-70*

*6-27* 19*70*  
date well completed

*Ed Clark*  
firm name

*Union*  
county well located

LANDOWNER:

*Gen Allen Kitchens*  
*New Albany*  
(mailing address)

description of formations encountered

from to

<i>Rock &amp; Sand</i>	<i>0</i>	<i>20</i>
<i>Blue mud</i>	<i>20</i>	<i>130</i>
<i>Rock &amp; Sand</i>	<i>130</i>	<i>260</i>
<i>Blue mud</i>	<i>260</i>	<i>370</i>
<i>Rock &amp; Sand</i>	<i>370</i>	<i>572</i>

WELL LOCATION:

sec. *15* T. *6* N. R. *3* E.  
*4* miles *N* of *New Albany*  
(distance) (direction) (nearest town)

WELL PURPOSE:

*Home*  
(home, irrigation, municipal, industrial)

WELL COMPLETION DATA:

- (1) diameter (inches) *4"*
- (2) total depth (feet) *572'*
- (3) static water level (feet) *Ground level* below above top of ground.
- (4) casing *metal, 27'* (material) (depth) *well*  
*4"* if telescope see back. (size)
- (5) screen *None* (length) (depth to top)
- (6) pump *No Pump Installed* (size) (material) (HP) (yield gpm)  
*Electric* (type power)
- (7) electric log *no* (yes or no)  
(organization running log)
- (8) how well bottom plugged *no*

**CODED**


JUL 1 1970

DRILLERS REMARKS:

MISS. BD. OF  
WATER COM.

If well telescopes please sketch and show depths.

GROUND LEVEL

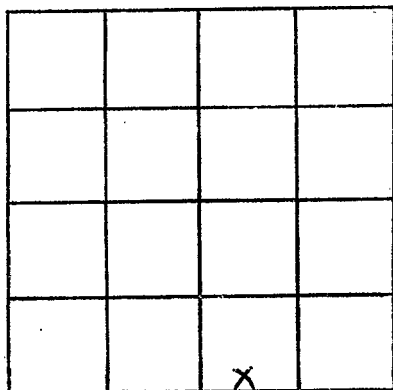

SECTION \_\_\_\_\_

Please indicate well location X.

ADDITIONAL INFORMATION

If more than one screen, show locations of each on sketch.