

MISSISSIPPI  
BOARD OF WATER COMMISSIONERS  
416 North State Street  
Jackson, Mississippi 39201

**CODED**

UNION  
C23  
11-14-70

WATER WELL DRILLERS LOG

Nov. 14 1970 Ed. Clark Co. Union  
date well completed firm name county well located

LANDOWNER:

Charles Little  
New Albany, Nante  
(mailing address)

description of formations encountered

from to

Red Clay	0	25
Blue mud	25	90
Rock & sand	90	122
Blue mud	122	550
Rock & sand	550	550

WELL LOCATION:

sec. 25 T. 6 R. 3 E  
8 miles NE of New Albany  
(distance) (direction) (nearest town)

WELL PURPOSE:

Home  
(home, irrigation, municipal, industrial)

WELL COMPLETION DATA:

- (1) diameter (inches) 4"
- (2) total depth (feet) 550'
- (3) static water level (feet) 70' below top of ground.
- (4) casing Metal, 122' (material) (depth)  
4" (size) if telescope see back.
- (5) screen None (length) (depth to top)
- (6) pump 1/2 (HP) 3 (yield gpm)  
Electric (type power)
- (7) electric log No (yes or no)

**CODED**

JAN 4 - 1971


MISS. BD. OF  
WATER COMMISSIONERS

DRILLERS REMARKS:

(organization running log)  
(8) how well bottom plugged No

If well telescopes please sketch and show depths.

GROUND LEVEL

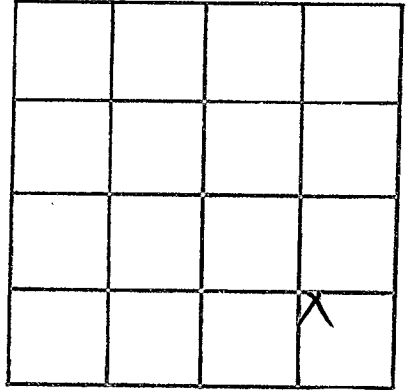

SECTION \_\_\_\_\_

Please indicate well location X.

ADDITIONAL INFORMATION

If more than one screen,  
show locations of each on sketch.