

UNION
C 26
9-10-61

WATER WELL DRILLERS LOG

CODED

Date: Sept. 10, 1961, Driller: ED CLARR County Union

(Name)

EMMERT OWEN

(1) Owner of Land: Emmert Owen
(Name)

new albony miss
(Address)

(2) Location: 5 65 32
1/4, 1/4, Sec. T R

8 miles north, of new albony
(distance) (direction) (Nearest Town)

(3) Topography: Hilly
(Hilly) (Flat) (Level)

(4) Purpose of Well: Home well
(Domestic Irrigation
Municipal, Industrial, Other)

Description & Color of Materials Sand, Clay, Red Clay, Shell, etc.	Thick- ness Feet	Depth Feet
<u>Red clay.</u>	<u>30</u>	<u>30</u>
<u>Sand Rock Blue Pine</u>	<u>54</u>	<u>84</u>
<u>Blue mar</u>		<u>84</u>
<u>Rock Sand & shell</u>	<u>40</u>	<u>150</u>

Information upon completion of well:

(1) Diameter 4 inches.

(2) Total Depth 190 feet.

(3) Water Level 50 feet below top of ground.

(4) Cased to 84, Size 4

(5) Screen: Size _____, Length _____

(6) Were any formations sealed against pollution?


X yes, _____ no.

If YES depth of formation 60 ft

Why Lordy Ho Downard

Drillers Remarks:

CODED

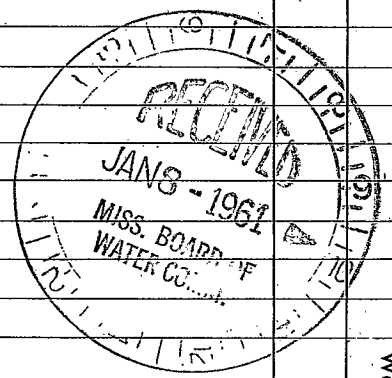

(Use Back Side)

Well No.

