

C27

CODED

WATER WELL DRILLERS LOG

10-28-63

Date: 10-28, 19 63 Driller: C F CARLISLE County UNION

(Name)

(1) Owner of Land: KC KIMMONS
(Name) MISS
NEW ALBANY R-4
(Address)

(2) Location: 1/4, 1/4, Sec. T. R.
4 65 3E
miles of
(distance) (direction) (Nearest Town)

(3) Topography: X
(Hilly) (Flat) (Level)

(4) Purpose of Well: DOMESTIC
(Domestic Irrigation
Municipal, Industrial, Other)

Description & Color of Materials Sand, Clay, Red Clay, Shell, etc.	Thick- ness Feet	Depth Feet
GUMBO	25	25
ROCK	35	60
BLUEDIRT	80	140
W ROCK	9	149
W SAND	30	179

Information upon completion of well:

- (1) Diameter 4 inches.
- (2) Total Depth 172 feet.
- (3) Water Level 15 feet below top of ground.
- (4) Cased to 84, Size
- (5) Screen: Size, Length
- (6) Were any formations sealed against pollution?


yes, no.

If YES depth of formation

Why

Drillers Remarks:

CODED

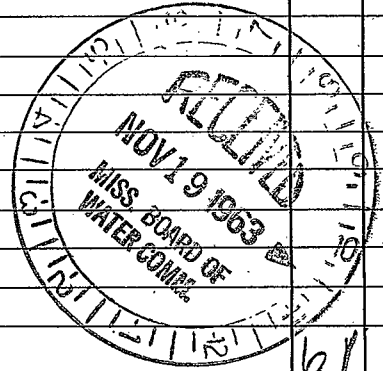

(Use Back Side)

Well No.

101

