

Coded

UNION
C 31
3-68

MISSISSIPPI
BOARD OF WATER COMMISSIONERS
416 North State Street
Jackson, Mississippi 39201

WATER WELL DRILLERS LOG

CODING

3-7 1968 Ed Clark date well completed firm name county well located in

LANDOWNER: Entel

Piston Plant
RR 3 New Albany
(mailing address)

description of formations encountered	from	to
Red Clay	0	20
Rock & Spuff	20	180
Blue mud	180	619
Rock & Sand	619	689


WELL LOCATION:
sec. 21 T. 6 N. R. 3 E
S
2 miles N of N.A.
(distance) (direction) (nearest town)

WELL PURPOSE:
(home, irrigation, municipal, industrial)

WELL COMPLETION DATA: 27

- (1) diameter (inches) 6"
- (2) total depth (feet) 689'
- (3) static water level (feet) 10 below top of ground.
- (4) casing METAL, 180, (material), (depth),
NO (size) if telescope see back.
- (5) screen NO (length), NO (depth to top)
(size), (material)
- (6) pump 5 (HP), 100 (yield gpm)
Elect. (type power)
- (7) electric log NO (yes or no)
(organization running log)
- (8) how well bottom plugged NO

CODING

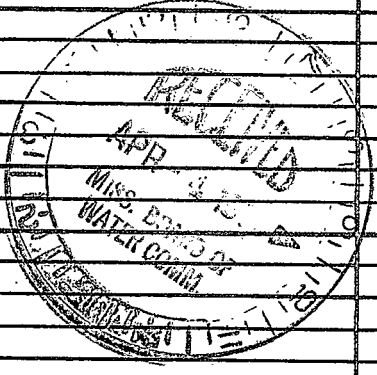


DRILLERS REMARKS:

(Y)

If well telescopes please sketch and show depths.

GROUND LEVEL

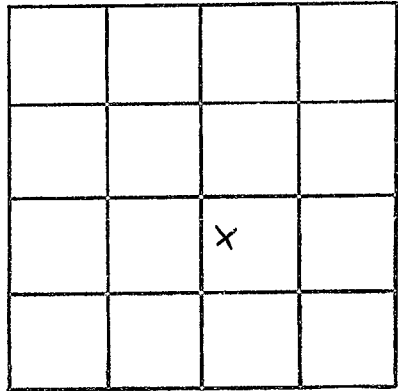

SECTION 21

Please indicate well location X.

ADDITIONAL INFORMATION

If more than one screen, show locations of each on sketch.