

Union  
 C33  
 7-68

MISSISSIPPI  
 BOARD OF WATER COMMISSIONERS  
 416 North State Street  
 Jackson, Mississippi 39201

WATER WELL DRILLERS LOG

CODED

7-21-1968 date well completed  
 J T medin firm name  
 Union county well located

LANDOWNER: Mr. Hickman

New Albany  
 Mississippi  
 (mailing address)

WELL LOCATION:

sec. 3 T. 14 N. R. 3 E  
 3 miles E of Cotton Plant  
 (distance) (direction) (nearest town)


WELL PURPOSE: domestic  
 (home, irrigation, municipal, industrial)

WELL COMPLETION DATA:

- (1) diameter (inches) 4 inch
- (2) total depth (feet) 280
- (3) static water level (feet) 0 F. below above top of ground: 60
- (4) casing Plastic 280  
 (material) (depth)  
 (size) If telescope see back.
- (5) screen \_\_\_\_\_  
 (length) (depth to top).  
 (size) (material)
- (6) pump 0 F. 4 GPM  
 (HP) (yield gpm)  
 (type power)
- (7) electric log \_\_\_\_\_  
 (yes or no)  
 (organization running log)
- (8) how well bottom plugged blue dirt

description of formations encountered	from	to
red clay	0	12
sack - sand	12	38
blue clay	38	120
white sand shell	120	135
blue clay	135	190
white sand shell	190	205
blue clay	205	265
white sand shell	265	280


CODED

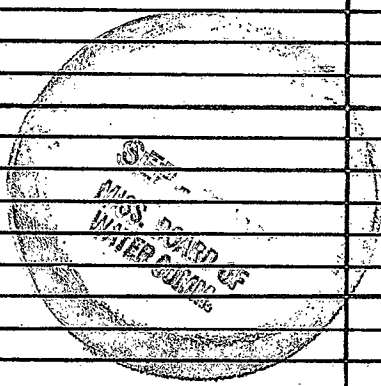

DRILLERS REMARKS:

If well telescopes please sketch and show depths.

GROUND LEVEL

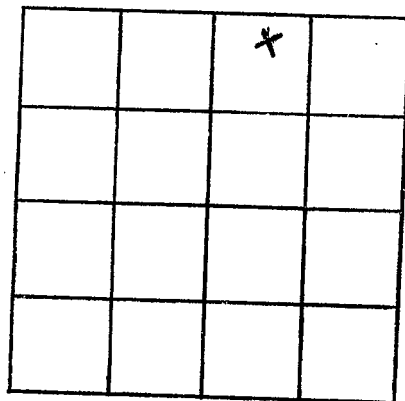

SECTION \_\_\_\_\_

Please indicate well location X.

ADDITIONAL INFORMATION

If more than one screen, show locations of each on sketch.