

UNION

C 35

WATER WELL DRILLERS LOG

Date: 1-22-62, 1962 Driller: B F Carls

CODED

(1) Owner of Land: Grace Kitchens
 (Name)

 (Address)

(2) Location: $\frac{1}{4}$ SW $\frac{1}{4}$ Sec. 36 T $\frac{1}{2}$ R 3
5 miles E of NA
 (distance) (direction) (Nearest Town)

(3) Topography: X
 (Hilly) (Flat) (Level)

(4) Purpose of Well: DOM
 (Domestic Irrigation
 Municipal, Industrial, Other)

Description & Color of Materials Sand, Clay, Red Clay, Shell, etc.	Thick- ness Feet	Depth Feet
RED CLAY	20	20
BLUE DIRT	20	40
ROCK	50	90
LIME ROCK	210	300
CHALK	320	620
W. ROCK	2	622
W SAND	43	665

Information upon completion of well:

(1) Diameter 4 inches.

(2) Total Depth 665 feet.

(3) Water Level 90 feet below top of ground.


(4) Cased to 126, Size 4

(5) Screen: Size _____, Length _____

(6) Were any formations sealed against pollution?
 _____ yes, _____ no.

CODED

If YES depth of formation _____
 Why _____
 Drillers Remarks: _____

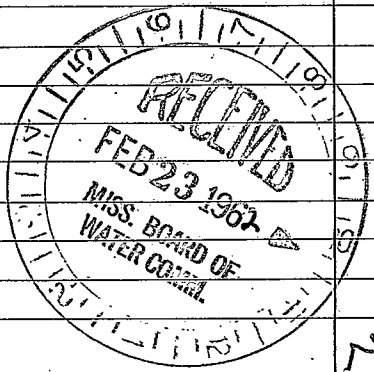

(Use Back Side)

22

Well No.

1950

1951

1952

2040