

Union
C 40
10-9-72

MISSISSIPPI
BOARD OF WATER COMMISSIONERS
416 North State Street
Jackson, Mississippi 39201

1160.00
62.00
1122.00

WATER WELL DRILLERS LOG

CODED

10-9-1972 date well completed
J T Medlin firm name
county well located

LANDOWNER:
Thomas Wecker
New Albany
(mailing address)

description of formations encountered	from	to
Clay	0	80
rock & clay	80	120
Blue li	120	180
rock & sand	180	300

WELL LOCATION:
sec. 7 T. 6 N. R. 3 E
4 miles W of Cotton Plant
(distance) (direction) (nearest town)

WELL PURPOSE:
(home, irrigation, municipal, industrial)

WELL COMPLETION DATA:

(1) diameter (inches) 4

(2) total depth (feet) 300

(3) static water level (feet) 20 below top of ground

(4) casing P 300 (material) (depth)
If telescope see back.
(size)

(5) screen 10 390 (length) (depth to top)
4 P (size) (material)

(6) pump 1 1/2 6 (HP) (yield gpm)
E (type power)

(7) electric log (yes or no)
(organization running log)

(8) how well bottom plugged


CODED

DRILLERS REMARKS:

FEB 21 1972

If well telescopes please sketch and show depths.

GROUND LEVEL

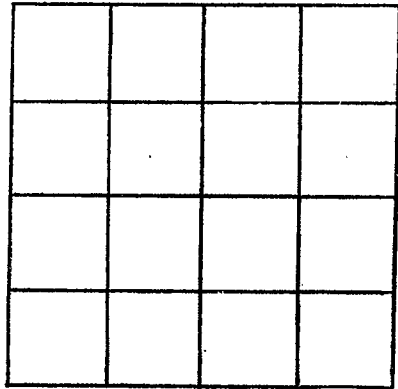

SECTION _____

Please indicate well location X.

ADDITIONAL INFORMATION

A series of horizontal lines providing space for additional information.

If more than one screen, show locations of each on sketch.