

UNION
C43
7-29-74

MISSISSIPPI
 BOARD OF WATER COMMISSIONERS
 416 North State Street
 Jackson, Mississippi 39201

CODED

WATER WELL DRILLERS LOG

July 24 1974 J.W. Webb & Sons Union
 date well completed firm name county well located

LANDOWNER: Armentie J Moore

description of formations encountered	from	to
---------------------------------------	------	----

New Albany
 (mailing address)

Soil	0	1
Sand & Clay	1	24
Blue Sand & Rock	24	65
Shall & Sand	65	141
Blue Rock	141	180
Yellow Sand	180	260
Ripley Sand		

WELL LOCATION:
 sec. 7 T. 65 N R. 3 E
2 miles west of Attapulgus
 (distance) (direction) (nearest town)

WELL PURPOSE:
 (home, irrigation, municipal, industrial)

WELL COMPLETION DATA:

- (1) diameter (inches) 4"
- (2) total depth (feet) 260
- (3) static water level (feet) 74 below top of ground.
- (4) casing Steel 147ft
 (material) (depth)
4" if telescope see back.
 (size)
- (5) screen 0 0
 (length) (depth to top)
 (size) (material)
- (6) pump 1 1/2 hp 4
 (HP) (yield gpm)
Elec
 (type power)
- (7) electric log _____
 (yes or no)
 (organization running log)
- (8) how well bottom plugged _____

CODED


RECEIVED
AUG - 8 1974

DRILLERS REMARKS:

MISS. Bd. OF WATER COM.

If well telescopes please sketch and show depths.

GROUND LEVEL

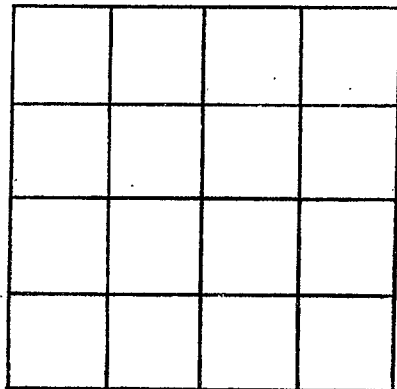

SECTION _____

Please indicate well location X.

ADDITIONAL INFORMATION

If more than one screen, show locations of each on sketch.