

UNION

C 44

4-24-74

MISSISSIPPI
 BOARD OF WATER COMMISSIONERS
 416 North State Street
 Jackson, Mississippi 39201

CODED

WATER WELL DRILLERS LOG

April 24 1974
date well completed

J. W. Webb & Son
firm name

Union
county well located

LANDOWNER: George Dunca
new alhany

(mailing address)

WELL LOCATION:

sec. 17 T. 6 N R. 3 E
 1 miles west of Cotton plant
 (distance) (direction) (nearest town)

WELL PURPOSE:

(home, irrigation, municipal, industrial)

WELL COMPLETION DATA:

- (1) diameter (inches) 4
- (2) total depth (feet) 260
- (3) static water level (feet) 77 below above top of ground.
- (4) casing steel 34 ft
(material) (depth)
4 in if telescope see back.
(size)
- (5) screen 0 0
(length) (depth to top)
(size) (material)
- (6) pump 1/2 HP Sub 8
(HP) (yield gpm)
5 hp
(type power)
- (7) electric log _____
(yes or no)
(organization running log)
- (8) how well bottom plugged _____

description of formations encountered

from to

Sol	0	1
Sand & Clay	1	26
Shell & Sand	26	80
Blue Rock	80	145
Water Sand & Rocks	145	260
Ripley sand		

CODED


RECEIVED
AUG - 6 1974

DRILLERS REMARKS:

MISS. BD. OF WATER COMMISSIONERS

If well telescopes please sketch and show depths.

GROUND LEVEL

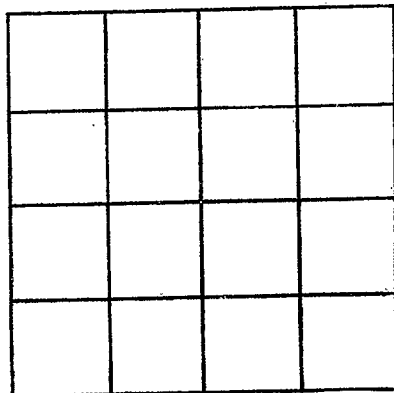

SECTION _____

Please indicate well location X.

ADDITIONAL INFORMATION

If more than one screen,
show locations of each on sketch.