

UNION  
C 46  
1-15-75

MISSISSIPPI  
BOARD OF WATER COMMISSIONERS  
416 North State Street  
Jackson, Mississippi 39201

\$00 00  
40 00

WATER WELL DRILLERS LOG

1 15 1975 J. T. Medlin U. MISSISSIPPI  
date well completed firm name county well located


2 1/2 mi. N of New Albany

LANDOWNER:	description of formations encountered	from	to
James Coates Cotton Plant #4	Clay	0	18
	Rocky Clay	18	30
	Blue Shale	30	175
	Red K& Sand	175	230
(mailing address)			
WELL LOCATION:			
sec. 17 T. 6 N. R. 3 E.			
3 miles SW of Cotton Plant			
(distance) (direction) (nearest town)			
WELL PURPOSE:			
(home, irrigation, municipal, industrial)			
WELL COMPLETION DATA:			
(1) diameter (inches) 4			
(2) total depth (feet) 230			
(3) static water level (feet) 55 below top of ground.			
(4) casing (material) P (depth) 120			
(size) If telescope see back.			
(5) screen (length) (depth to top)			
(size) (material)			
(6) pump (HP) 2 (yield gpm) 6			
(type power) E			
(7) electric log (yes or no)			
(organization running log)			
(8) how well bottom plugged			
DRILLERS REMARKS:			

RECEIVED  
MAR 20 1975

If well telescopes please sketch and show depths.

GROUND LEVEL

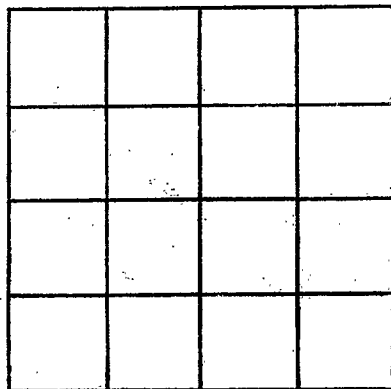

SECTION \_\_\_\_\_

Please indicate well location X.

ADDITIONAL INFORMATION

If more than one screen, show locations of each on sketch.