

UNION

C 48 49

9-23-75

MISSISSIPPI  
 BOARD OF WATER COMMISSIONERS  
 416 North State Street  
 Jackson, Mississippi 39201

WATER WELL DRILLERS LOG

Sept. 23 1975

J. T. McMillin

Union

date well completed

firm name

county well located

LANDOWNER:

Bobby Farr

Highway 175

(mailing address)

WELL LOCATION:

sec 18 T 6 N R 3 E  
 Pinken Center  
 miles of (distance) (direction) (nearest town)

WELL PURPOSE:

(home, irrigation, municipal, industrial)

WELL COMPLETION DATA:

- (1) diameter (inches) 4
- (2) total depth (feet) 170
- (3) static water level (feet) 40 below top of ground.
- (4) casing (material) 75 ft (depth)
- (size) if telescope see back.
- (5) screen (length) (depth to top)
- (size) (material)
- (6) pump (HP) (yield gpm)
- (type power)
- (7) electric log (yes or no)
- (organization running log)
- (8) how well bottom plugged

description of formations encountered

from

to

Clay

0 11

Rock & Clay

19 80


SHALLOO

60 135

Rock & Sand

135 170

3 Miles North of Pinken Center

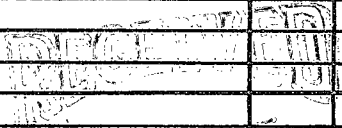


OCT 16 1975

DRILLERS REMARKS:

If well telescopes please  
sketch and show depths.

GROUND LEVEL

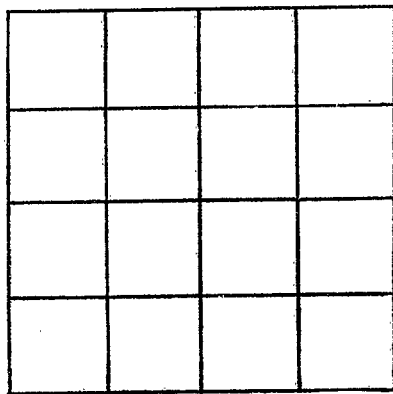

SECTION \_\_\_\_\_

Please indicate well location X.

ADDITIONAL INFORMATION

If more than one screen,  
show locations of each on sketch.