

MISSISSIPPI DEPARTMENT OF NATURAL RESOURCES  
 Bureau of Land and Water Resources  
 Southport Mall  
 P.O. Box 10631  
 Jackson, Mississippi 39209  
**WATER WELL DRILLERS LOG**

**CODED**

UNION  
 C50  
 8/80  
 Log #33

August 1980 J. W. WEBB & SONS UNION  
 date well completed firm name county well located

LANDOWNER:  
 PIPER INDUSTRIES  
 NEW ALBANY, MISS  
 (mailing address)

description of formations encountered	from	to
RED SAND & CLAY	0	30
SANDY CLAY	30	60
SAND & CLAY	60	90
CLAY & ROCK	90	120
" "	120	150
CLAY	150	600
CLAY & SAND	600	630
SAND	630	670
CLAY	670	720
SAND	720	800
CLAY	800	900

WELL LOCATION:  
 sec. 21 T. 6 S. R. 3 E.  
 3 miles N of NEW ALBANY  
 (distance) (direction) (nearest town)

WELL PURPOSE: INDUSTRIAL  
 (home, irrigation, municipal, industrial)

WELL COMPLETION DATA:

- (1) diameter (inches) 10"
- (2) total depth (feet) 800'
- (3) static water level (feet) \_\_\_\_\_ below above top of ground.
- (4) casing STEEL, 700' (material) (depth)  
 \_\_\_\_\_ if telescope see back.  
 (size)
- (5) screen 80' 720' (length) (depth to top)  
 4" 5.5 (size) (material)
- (6) pump 40 250 (HP) (yield gpm)  
 ELECTRIC (type power)
- (7) electric log YES (yes or no)  
 MISS. GEO. SURVEY (organization running log)
- (8) how well bottom plugged BACK WASH VALVE

**CODED**

DEPT. OF NATURAL RESOURCES  
 BUREAU OF LAND & WATER RESOURCES

NOV 25 1981


DRILLERS REMARKS:

**RECEIVED**

(X)

If well telescopes please sketch and show depths.

GROUND LEVEL

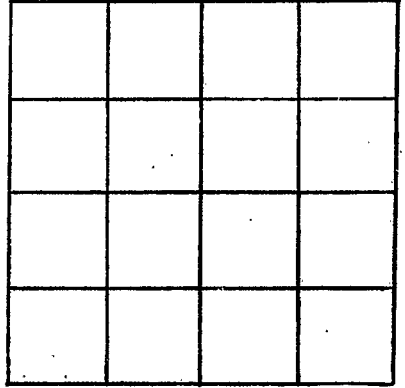

SECTION 21

Please indicate well location X.

ADDITIONAL INFORMATION

If more than one screen,  
show locations of each on sketch.