

MISSISSIPPI DEPARTMENT OF NATURAL RESOURCES 3

Bureau of Land and Water Resources

Southport Mall

P.O. Box 10631

Jackson, Mississippi 39209

WATER WELL DRILLERS LOG

CODED

UNION
C 51
9-14-81

9-14-1981 date well completed LEEPER Drilling Co firm name UNION county well located

LANDOWNER: ERTEL
Manufacturing Co
New Albany MS
(mailing address)

description of formations encountered	from	to
Top clay	0	10
Red sand	10	17
Blue clay	17	26
Coarse sand	26	50
Fine sand	50	80
Soft Blue clay	80	300
Chalk	300	595
Sand	595	640
clay	640	646

WELL LOCATION:
sec. 21 T. 6 N. R. 30 E.
4 miles (distance) N (direction) of New Albany (nearest town)

WELL PURPOSE: industrial
(home, irrigation, municipal, industrial)

WELL COMPLETION DATA:

(1) diameter (inches) 4"

(2) total depth (feet) 646'

(3) static water level (feet) 140 below top of ground.

(4) casing PVC 616
(material) (depth)
4"
(size) If telescope see back.

(5) screen 30' 616
(length) (depth to top)
4" PVC
(size) (material)

(6) pump 5 30
(HP) (yield gpm)
electric
(type power)

(7) electric log YES
(yes or no)
STATE of Miss
(organization running log)

(8) how well bottom plugged CAP


DRILLERS REMARKS:

DEPT. OF NATURAL RESOURCES
BUREAU OF LAND & WATER RESOURCES

OCT 15 1981
RECEIVED

If well telescopes please
sketch and show depths.

GROUND LEVEL

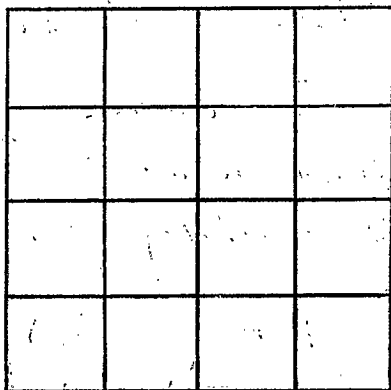

SECTION _____

Please indicate well location X.

ADDITIONAL INFORMATION

If more than one screen,
show locations of each on sketch.