

MISSISSIPPI DEPARTMENT OF NATURAL RESOURCES

Bureau of Land and Water Resources

Southport Mall

P.O. Box 10631

Jackson, Mississippi 39209

WATER WELL DRILLERS LOG

UNION
C.52
3/90

MARCH 19 90 J.W. WEBB & SONS UNION
 date well completed firm name county well located

LANDOWNER:	description of formations encountered	from	to
NORTH HAVEN WATER ASSOC.	RED CLAY	0	30
NEW ALBANY MS. (mailing address)	RED SANDY CLAY	30	60
	BLUE CLAY	60	90
WELL LOCATION:	SANDY BLUE CLAY	90	120
sec. 16 T 6 S R 3 E	SAND & ROCK	120	210
4 miles North of NEW ALBANY	SANDY CLAY & SHALE	210	300
(distance) (direction) (nearest town)	BLUE CLAY	300	480
WELL PURPOSE: (home, irrigation, municipal, industrial)	SANDY CLAY	480	660
	SANDY CLAY & SAND	660	790
WELL COMPLETION DATA:	SAND	790	860
(1) diameter (inches) 10	BLUE CLAY	860	890
(2) total depth (feet) 851			
(3) static water level (feet) 239 below top of ground.			
(4) casing STEEL 787 (material) (depth)			
(size) If telescope see back.			
(5) screen 60' 789 (length) (depth to top)			
6" 55 (size) (material)			
(6) pump 50 200 (HP) (yield gpm)			
ELECTRIC (type power)			
(7) electric log YES (yes or no)			
STATE (organization running log)			
(8) how well bottom plugged BACK WASH VALVE			

RECEIVED


FEB 04 1990

Dept. of Environmental Quality
 Bureau of Land & Water Resources

DRILLERS REMARKS:

If well telescopes please sketch and show depths.

GROUND LEVEL

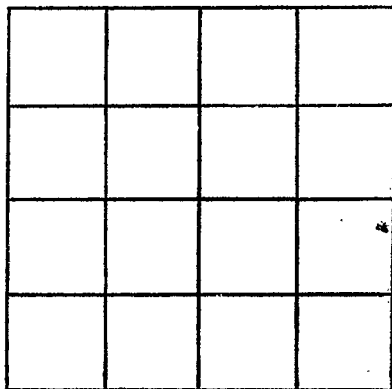

SECTION 16

Please indicate well location X.

ADDITIONAL INFORMATION

If more than one screen,
show locations of each on sketch.