

**UNION**  
**G60**  
**5-1-72**

MISSISSIPPI  
 BOARD OF WATER COMMISSIONERS  
 416 North State Street  
 Jackson, Mississippi 39201

**CODED**

WATER WELL DRILLERS LOG

may 1 19 72 J. W. Webbyson Union  
 date well completed firm name county well located

LANDOWNER: Lawrence  
 Lawrence Johnson  
 New Albany  
 (mailing address)

description of formations encountered	from	to
Soil	0	1
Sand & Shell	1	51
Blue Rock	51	101
Water Rock	101	103
Water Sand & Rock	103	168
or Ripley Sand		
enter		

WELL LOCATION:  
 sec. 30 T 6 N R 3 E  
 1/2 miles North of Poppo  
 (distance) (direction) (nearest town)

WELL PURPOSE:  
 (home, irrigation, municipal, industrial)

- WELL COMPLETION DATA:
- (1) diameter (inches) 4"
  - (2) total depth (feet) 168
  - (3) static water level (feet) 69 below top of ground.
  - (4) casing Steel 63 ft (material) (depth)  
 4" (size) if telescope see back.
  - (5) screen 0 (length) 0 (depth to top)  
 0 (size) 0 (material)
  - (6) pump 1 1/2 hp 6 (HP) (yield gpm)  
 Elec (type power)
  - (7) electric log no (yes or no)
  - (8) how well bottom plugged

**CODED**


JUN 10 1972

DRILLERS REMARKS:

MISSISSIPPI  
 BOARD OF WATER COMMISSIONERS

If well telescopes please sketch and show depths.

GROUND LEVEL

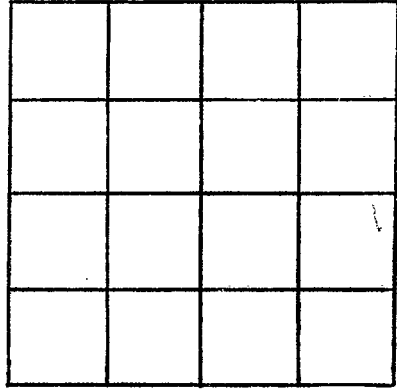

SECTION \_\_\_\_\_

Please indicate well location X.

ADDITIONAL INFORMATION

If more than one screen, show locations of each on sketch.