

State Well Report

Part I

Mississippi Department of Environmental Quality
Office of Land and Water Resources
P.O. Box 10631
Jackson, MS 39289-0631
(601)961-5210
(601)354-6938 (fax)

For Office Use Only:

Aquifer: _____
Well #: C-62
L. S. Elevation: _____
E-log #: _____

County: Union
Permit #: _____
Driller: Leaper Drilling
Date drilling completed: 7-30-07

State Law requires that this report be prepared by the driller in detail and filed with the Department within 30 days of completion of drilling of the well.

Well Owner Information	Well Location
Owner Name: <u>Lewis Sacran</u>	Latitude: _____ Longitude: _____
Mailing Address: <u>27 CR 144</u>	Method of Lat/Long (circle one): Conventional Survey, USGS quad, Hand-held GPS, Survey-grade GPS
<u>New Albany MS 38652</u> City State Zip Code	_____ 1/4 _____ 1/4 Sec <u>11</u> Twn <u>6S</u> Rng <u>3E</u>
Telephone No. <u>(663) 316-1100</u>	Distance Direction Nearest Town <u>6</u> Miles <u>NW</u> of <u>New Albany</u>

Well Data

Purpose of Well (circle one) Home Industrial Public Supply Irrigation Fish Culture Other: _____

Date well drilling started: 7-30-07 Date well drilling completed: 7/30/07

If flowing, method of flow regulation: Valve _____ Other (describe) _____

Static Water Level: 50 feet above or below (circle one) land surface Date measured: 7-31-07

Method of Measurement (circle one) steel tape electric tape air line other: _____

Hole depth: 200 Well depth: _____ Well grouted to a depth of _____ feet

Type of grout (circle one): Cement Bentonite Mix

Casing length: 180 feet Casing diameter: 4" inches Type of casing: PVC

Screen length: 20 feet Screen diameter: 4" inches Type of screen: PVC

Screen slot size: .013 inches Setting depth: From _____ feet to _____ feet

Type of completion (circle all applicable): Gravel packed Underreamed Telescoped Open hole Natural Development
Other (describe): _____

Top of lap pipe or reduction in casing: _____ feet. If telescoped or more than one screen, describe on back of page

Logs run (circle all applicable): No log run Electric Gamma Ray Density Sonic Neutron Other: _____

Name of organization running log(s): _____


I certify that the well was drilled, constructed, and completed in accordance with all applicable requirements of the Mississippi Department of Environmental Quality and/or the Mississippi Department of Health regulations and state laws.

Leaper Drilling #0079
Print Name of Water Well Contractor and License No.

[Signature]
Signature of Water Well Contractor

C-62


If well telescopes please sketch below and show depths.

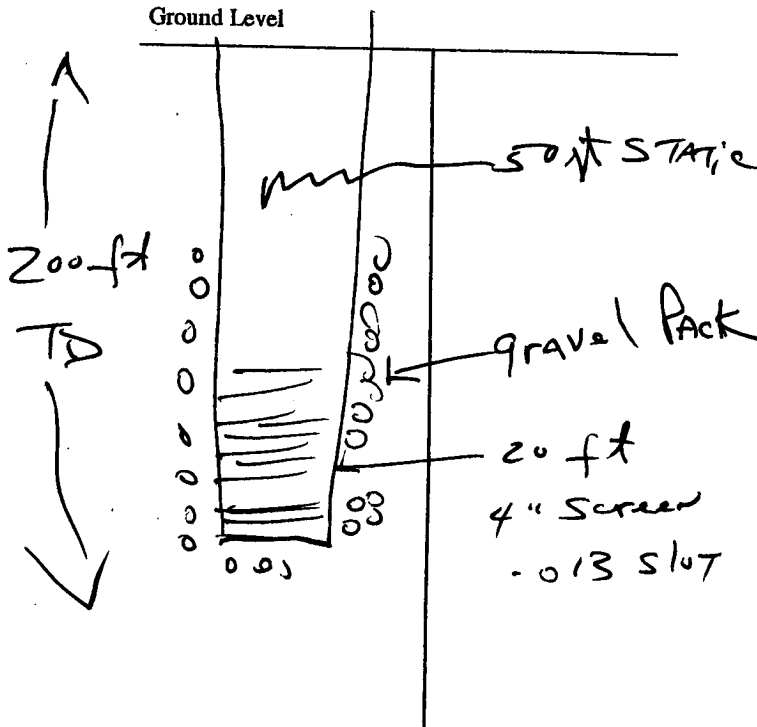

Description of Formations Encountered	From	To
TOP CLAY	0	30
Blue clay	30	140
SILTY SAND	140	180
SAND	180	200

If more than one screen, show location of each on sketch

Sketch the property layout and include the following: 1) the well location; 2) any permanent structures on the property that may aid in locating the well; 3) any roads, power lines, or other items that may aid in locating the property and the well; 4) indicate direction.

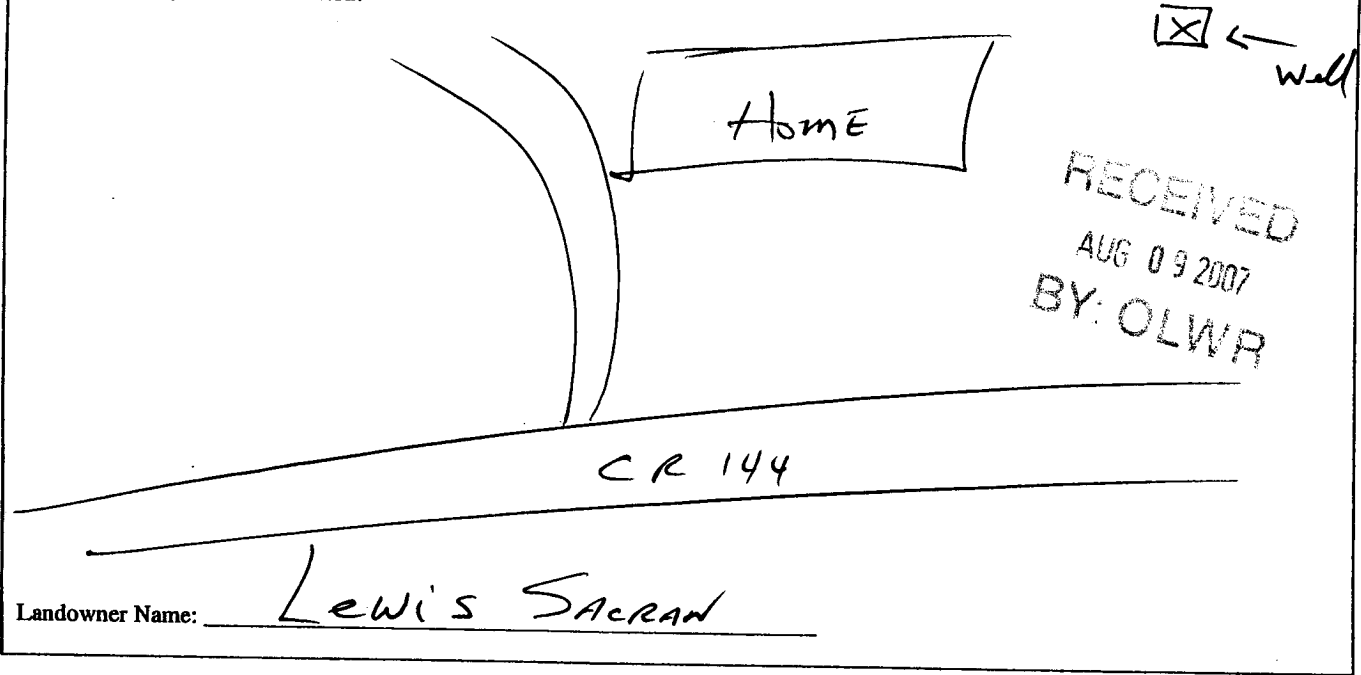

Signature of Water Well Contractor

[Handwritten Signature]

STATE WELL REPORT

Part 2

Pump Installer's Completion Report
Mississippi Department of Environmental Quality
Office of Land and Water Resources
P.O. Box 10631
Jackson, MS 39289-0631
(601)961-5210
(601)354-6938 (fax)

County: UNION
Permit #: _____
Driller: Leeper Drilling
Date completed: 7-31-07

For Office Use Only:
Aquifer: _____
Well #: C-62
Elevation: _____

This report should be prepared by the pump installer in detail and filed with the Department within 30 days of the installation of pump.

Well Owner Information	Well Location
Owner Name: <u>Lewis Sacran</u>	Latitude: _____ Longitude: _____
Mailing Address: <u>27 CR 144</u>	Method of Lat/Long (circle one): Conventional Survey, USGS quad, Hand-held GPS, Survey-grade GPS
<u>New Albany MS 38652</u> City State Zip Code	_____ 1/4 _____ 1/4 Sec <u>11</u> Twn <u>63</u> Rng <u>3E</u>
Telephone No. <u>(662) 316-1100</u>	Distance Direction Nearest Town <u>6</u> Miles <u>NW</u> of <u>New Albany</u>

Pump Type Circle one	Power Type Circle one
Air Lift Jet <u>Submersible</u>	Diesel Engine Gasoline Engine Natural Gas
Bucket Piston Turbine	<u>Electric Motor</u> Hand Tractor PTO
Centrifugal Rotary Flowing Well	Windmill Other (specify): _____
Other (specify): _____	Horse Power Rating of Motor: <u>3/4 HP</u>
Date Pump Installed: <u>7-31-07</u>	Setting Depth: <u>120</u> feet
Rated Pump Capacity: <u>10</u> Gallons Per Minute	Number of Stages: <u>11</u>

Pump Test Data	Method of Measuring Water Level Circle one
Date Well Tested: <u>7-31-07</u>	Air Line Electric Measuring Line <u>Steel Tape</u>
Static Water Level (A): <u>50</u> Feet Below Land Surface	Other (specify): _____
Pumping Water Level (B): _____ Feet Below Land Surface	For flowing well, measured shut in head: _____ feet
Drawdown [(B) - (A)]: _____ Feet Below Land Surface	Well yielded _____ GPM with a drawdown of _____ feet after _____ hours of pumping
Test Pumping Rate: _____ Gallons Per Minute	
Duration of Pump Test (minimum 4 hours): _____ hours	

I HEREBY CERTIFY that the above statements are true to the best of my knowledge.
Leeper Drilling #0179
Print Name of Pump Installer and License No. (if applicable) _____
Signature of Pump Installer _____