

Union  
C 2000  
9/7/76

MISSISSIPPI  
 BOARD OF WATER COMMISSIONERS  
 416 North State Street  
 15F Jackson, Mississippi 39201

WATER WELL DRILLERS LOG

9/7/76 19 MEDIANWELL DRILLING UNION  
 date well completed firm name county well located

LANDOWNER: BELLAH  
CHURCH  
New Albany  
 (mailing address)

description of formations encountered	from	to
	<u>Clay</u>	<u>0</u>
<u>Blue Mud</u>	<u>50</u>	<u>260</u>
<u>hard rock</u>	<u>260</u>	<u>340</u>

WELL LOCATION:  
 sec. 16 N R 3E  
5 miles WEST of New Albany  
 (distance) (direction) (nearest town)

WELL PURPOSE: Druckstone  
 (home, irrigation, municipal, industrial)

- WELL COMPLETION DATA:
- diameter (inches) 4
  - total depth (feet) 340
  - static water level (feet) 90 <sup>below</sup> <sub>above</sub> top of ground.
  - casing Plastic 100 ft  
 (material) (depth)  
 (size) If telescope see back.
  - screen Ø Ø  
 (length) (depth to top)  
 (size) (material)
  - pump 1/2 Hp. 12  
 (HP) (yield gpm)  
 (type power)
  - electric log                       
 (yes or no)  
 (organization running log)
  - how well bottom plugged

if 3E will have to be (New Sect) of North of N.A.


**RECEIVED**

DEC 2 1976

DRILLERS REMARKS:

If well telescopes please sketch and show depths.

GROUND LEVEL

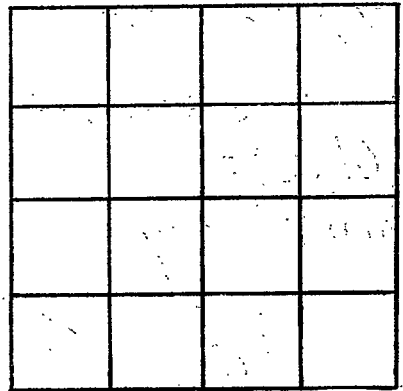

SECTION \_\_\_\_\_

Please indicate well location X.

ADDITIONAL INFORMATION

If more than one screen,  
show locations of each on sketch.