

UNION
C 2001
3/12/77

MISSISSIPPI
BOARD OF WATER COMMISSIONERS
416 North State Street
15F Jackson, Mississippi 39201

WATER WELL DRILLERS LOG

3/12/77 date well completed
27 Medlin Well Drilling Union firm name
county well located

LANDOWNER: FABER FARM, Inc.
Blue Mtn Ms.
(mailing address)

description of formations encountered	from	to
Clay	0	25
Bl. & Clay & Rock	25	60
Blue Clay	60	200
Sand & Rock	200	250

WELL LOCATION:
sec. 3 T. 6N. R. 3E
3 miles West of Cottawatch
(distance) (direction) (nearest town)

WELL PURPOSE:
(home, irrigation, municipal, industrial)


WELL COMPLETION DATA:
(1) diameter (inches) 4"
(2) total depth (feet) 250
(3) static water level (feet) 60 below top of ground above
(4) casing 4 (material) 110 (depth)
(size) If telescope see back.
(5) screen (length) (depth to top)
(size) 3 (material) 20
(6) pump 3/4 (HP) 20 (yield gpm)
elec.
(type power)
(7) electric log (yes or no)
(organization running log)
(8) how well bottom plugged open

DRILLERS REMARKS:

RECEIVED
AUG 24 1977
MISS. BD. OF WATER COMMISSIONERS

If well telescopes please sketch and show depths.

GROUND LEVEL

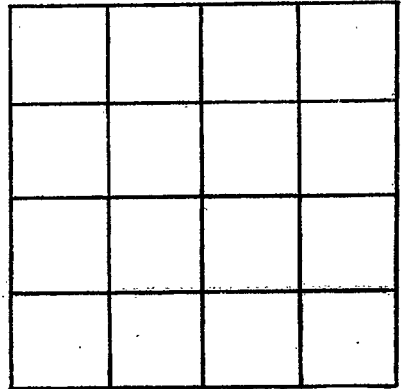

SECTION _____

Please indicate well location X.

ADDITIONAL INFORMATION

If more than one screen,
show locations of each on sketch.