

UNION

C2002

7-18-78

MISSISSIPPI BOARD OF WATER COMMISSIONERS  
416 North State Street  
Jackson, Mississippi 39201

WATER WELL DRILLERS LOG

July 18, 1978  
date well completed

J. W. Whitson  
firm name

Union  
county well located

LANDOWNER: Bobby Rakestraw  
new Albany

description of formations encountered

from

to

(mailing address)

WELL LOCATION:

sec. 12 T. 65 N. R. 3 E.  
S. W.  
2 miles South of new Albany  
(distance) (direction) (nearest town)

Soil	0	1
Sand & Clay	1	26
Sand Rock & Sand	26	62
Blue Rock	68	90
Hard Rock	90	94
Sand & Rock	94	199
Blue Rock	199	220
Replay sand		

WELL PURPOSE:

(home, irrigation, municipal, industrial)

WELL COMPLETION DATA:

- (1) diameter (inches) 4
- (2) total depth (feet) 220
- (3) static water level (feet) 65 below above top of ground.
- (4) casing steel 7 1/2"  
(material) (depth)
- If telescope see back.  
(size)
- (5) screen 0 0  
(length) (depth to top)
- 0 0  
(size) (material)
- (6) pump Herbet 7  
(HP) (yield gpm)
- Electric  
(type power)
- (7) electric log           
(yes or no)
- (organization running log)
- (8) how well bottom plugged

RECEIVED


AUG 10 1978

MISS. BD. OF WATER COMM

DRILLERS REMARKS:

If well telescopes please sketch and show depths.

GROUND LEVEL

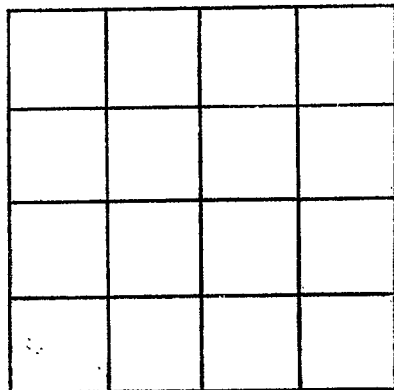

SECTION \_\_\_\_\_

Please indicate well location X.

ADDITIONAL INFORMATION

If more than one screen,  
show locations of each on sketch.