

UNION  
 C 2003  
 3/08/79

MISSISSIPPI  
 BOARD OF WATER COMMISSIONERS  
 416 North State Street  
 Jackson, Mississippi 39201

WATER WELL DRILLERS LOG

38 1979 date well completed  
 J T Medina firm name  
 Union county well located

LANDOWNER: Cecil Johnson  
 Blac Mt. R# 2.  
 (mailing address)

description of formations encountered	from	to
Clay	0	165
rock & sand	165	285
Clay	285	300
rock & sand	300	380

WELL LOCATION:  
 sec. 15 T 6 N R 3 E  
 4 miles W of Cotton Plant  
 (distance) (direction) (nearest town)

WELL PURPOSE:  
 (home, irrigation, municipal, industrial)

- WELL COMPLETION DATA:
- (1) diameter (inches) 4
  - (2) total depth (feet) 380
  - (3) static water level (feet) 70 below top of ground.
  - (4) casing P 140 (material) (depth)  
 (size) If telescope see back.
  - (5) screen (length) (depth to top)  
 (size) (material)
  - (6) pump 12 (HP) (yield gpm)  
 (type power)
  - (7) electric log (yes or no)
  - (organization running log)
  - (8) how well bottom plugged

DRILLERS REMARKS:


Miss. Board of Water Comm.

AUG 22 1979

RECEIVED

If well telescopes please sketch and show depths.

GROUND LEVEL

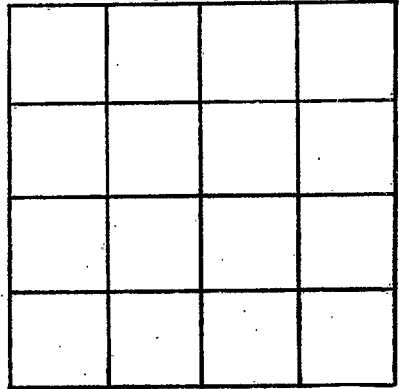

SECTION \_\_\_\_\_

Please indicate well location X.

ADDITIONAL INFORMATION

If more than one screen, show locations of each on sketch.