

Union
 C 2004
 9/28/79
 928

MISSISSIPPI
 BOARD OF WATER COMMISSIONERS
 416 North State Street
 Jackson, Mississippi 39201

WATER WELL DRILLERS LOG

date well completed 1979

firm name J. J. Neenan

county well located UNION

LANDOWNER

JOHN A HILL

description of formations encountered

from

to

R# 2 Blue mtn.

clay
 rock & sand

140
 140 230

Box 138A

(mailing address)

WELL LOCATION:

sec. 14 T 6 N R 3 E
 S W
 4 miles N of Keokukville
 (distance) (direction) (nearest town)

WELL PURPOSE:

(home, irrigation, municipal, industrial)

WELL COMPLETION DATA:

- (1) diameter (inches) 4
- (2) total depth (feet) 230
- (3) static water level (feet) 120 below top of ground
- (4) casing (material) P (depth) 230

(size) if telescope see back.

- (5) screen (length) 10 (depth to top) 220

(size) 4 (material) P

- (6) pump (HP) 5 (yield gpm) 8

(type power) E

- (7) electric log (yes or no)

(organization running log)


- (8) how well bottom plugged Corp

DRILLERS REMARKS:

10-4-79
 JW

If well telescopes please sketch and show depths.

GROUND LEVEL

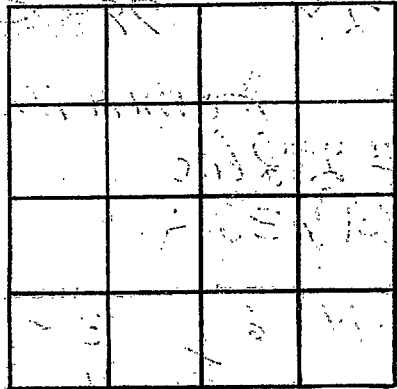

SECTION _____

Please indicate well location X.

ADDITIONAL INFORMATION

If more than one screen, show locations of each on sketch.