

UNION

MISSISSIPPI
BOARD OF WATER COMMISSIONERS
416 North State Street
Jackson, Mississippi 39201

WATER WELL DRILLERS LOG

3-18-80

March 18
date well completed

19 80 Madlin Water Well Co. Inc.
firm name

UNION
county well located

LANDOWNER: Roy Jordan
Old HWY 15 N
New Albany MS.
(mailing address)

description of formations encountered	from	to
Clay	0	18
Rock + Clay	18	185
ROCK + SAND	185	235

WELL LOCATION:
sec. 15 T. 6 N. R. 3 E.
5 miles West of Colburn MS.
(distance) (direction) (nearest town)

WELL PURPOSE:
(home, irrigation, municipal, industrial)

- WELL COMPLETION DATA:
- (1) diameter (inches) 4
 - (2) total depth (feet) 235
 - (3) static water level (feet) 20 below top of ground.
 - (4) casing P 220
(material) (depth)
 - (size) If telescope see back.
 - (5) screen 10 210
(length) (depth to top)
 - (size) (material)
 - (6) pump 5 8
(HP) (yield gpm)
 - (type power)
 - (7) electric log _____
(yes or no)
 - (organization running log)
 - (8) how well bottom plugged Cap

DEPT. OF NATURAL RESOURCES
BUREAU OF LAND & WATER RESOURCES


JUL 21 1980

RECEIVED

DRILLERS REMARKS:

If well telescopes please sketch and show depths.

GROUND LEVEL

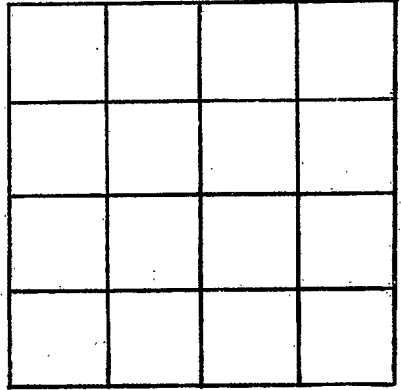

SECTION _____

Please indicate well location X.

ADDITIONAL INFORMATION

If more than one screen, show locations of each on sketch.