

UNION  
 Case  
 3-9-81

MISSISSIPPI  
 BOARD OF WATER COMMISSIONERS  
 416 North State Street  
 Jackson, Mississippi 39201

WATER WELL DRILLERS LOG

3-9-81 date well completed  
 T. T. Medlin firm name  
 UNION county well located

LANDOWNER:  
 Roger Mundy  
 522 Church St New Albany  
 38652 (mailing address)

description of formations encountered	from	to
SAND	6	90
CLAY - ROCK	90	180
CLAY - ROCK	180	310
ROCK - Shell-SAND	310	380

WELL LOCATION:  
 sec 26-6 N 3 E  
 6 miles of N-HAVEN  
 (distance) (direction) (nearest town)

WELL PURPOSE:  
 (home, irrigation, municipal, industrial)

WELL COMPLETION DATA:

- (1) diameter (inches) 4
- (2) total depth (feet) 380
- (3) static water level (feet) 80 below top of ground
- (4) casing PVC 180 (material) (depth)
- (size) If telescope see back.
- (5) screen (length) (depth to top) (size) (material)
- (6) pump 12 11 (HP) (yield gpm)
- E/C (type-power)
- (7) electric log (yes or no)

(organization running log)

(8) how well bottom plugged


DRILLERS REMARKS:

DEPT. OF NATURAL RESOURCES  
 BUREAU OF LAND & WATER RESOURCES

MAY 29 1981  
 RECEIVED

If well telescopes please sketch and show depths.

GROUND LEVEL

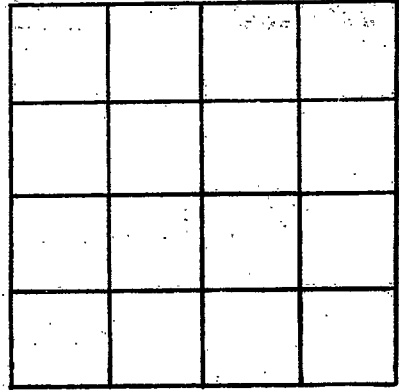

SECTION \_\_\_\_\_

Please indicate well location X.

ADDITIONAL INFORMATION

A series of horizontal lines for entering additional information, starting below the 'ADDITIONAL INFORMATION' header and extending to the bottom of the page.

If more than one screen, show locations of each on sketch.