

Union
 e
 2007

MISSISSIPPI
 BOARD OF WATER COMMISSIONERS
 416 North State Street
 Jackson, Mississippi 39201

WATER WELL DRILLERS-LOG

10-2-81 81 J.T. Wells Union
 date well completed firm name county well located

LANDOWNER:
 Paul McQuinn
 (mailing address)

description of formations encountered	from	to
crust of rock	0	100
clay - limestone	100	250
sand & limestone	250	380

WELL LOCATION:
 sec. 3 T 6 N R. 3 E
 3 miles (distance) S (direction) W (nearest town)

WELL PURPOSE:
 (home, irrigation, municipal, industrial)

WELL COMPLETION DATA:
 (1) diameter (inches) 4
 (2) total depth (feet) 380
 (3) static water level (feet) 80 below top of ground.
 (4) casing (material) PVC (depth) 190
 (size) If telescope see back.
 (5) screen (length) (depth to top)
 (size) (material)
 (6) pump (HP) 12 (yield gpm)
 (type power) ETC
 (7) electric log (yes or no)
 (organization running log)
 (8) how well bottom plugged

DRILLERS REMARKS:


DEPT. OF NATURAL RESOURCES
 BUREAU OF LAND & WATER RESOURCES

MAR 15 1982

RECEIVED

If well telescopes please sketch and show depths.

GROUND LEVEL

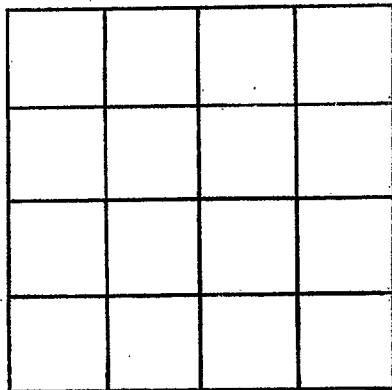

SECTION _____

Please indicate well location X.

ADDITIONAL INFORMATION

If more than one screen, show locations of each on sketch.