

MISSISSIPPI DEPARTMENT OF NATURAL RESOURCES

Bureau of Land and Water Resources

Southport Mall

P.O. Box 10631

Jackson, Mississippi 39209

WATER WELL DRILLERS LOG

Union
C
2008

5-1-1982 ST medlin UNION
date well completed firm name county well located

LANDOWNER:
Wayne Goolsby
Memphis Tenn.
(mailing address)

description of formations encountered	from	to
	sand rock	0
clay - rock - sand	130	190
sand -	190	210

WELL LOCATION:
sec. 13 T. 6 N. R. 3 E.
7 miles of Pleshin Ridge
(distance) (direction) (nearest town)

WELL PURPOSE:
(home, irrigation, municipal, industrial)

WELL COMPLETION DATA:

(1) diameter (inches) 4"

(2) total depth (feet) 210

(3) static water level (feet) 140 below top of ground.

(4) casing PVC 210 (material) (depth)

(size) if telescope see back.

(5) screen 10 200 (length) (depth to top)

4" PVC (size) (material)

(6) pump 1/2 8 (HP) (yield gpm)

Etc (type power)

(7) electric log (yes or no)

(organization running log) CAP

(8) how well bottom plugged

DEPT. OF NATURAL RESOURCES
BUREAU OF LAND & WATER RESOURCES


JUN 28 1982

DRILLERS REMARKS:

RECEIVED

If well telescopes please sketch and show depths.

GROUND LEVEL

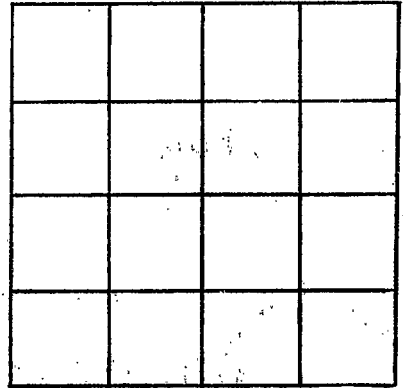

SECTION _____

Please indicate well location X.

ADDITIONAL INFORMATION

If more than one screen, show locations of each on sketch.