

MISSISSIPPI DEPARTMENT OF NATURAL RESOURCES

Bureau of Land and Water Resources

Southport Mall

P.O. Box 10631

Jackson, Mississippi 39209

WATER WELL DRILLERS LOG

Union
Coon

10-5-83
date well completed

Mull
firm name

Union
county well located

LANDOWNER:
Bryne Bradlett
Cotton Plant
(mailing address)

description of formations encountered	from	to
<u>Rock & sand</u>	<u>0</u>	<u>180</u>
<u>Clay</u>	<u>180</u>	<u>380</u>
<u>Rock</u>	<u>380</u>	<u>4</u>
<u>aquifer</u>	<u>180</u>	<u>380</u>

WELL LOCATION:
sec. 2 T. 6 N. R. 3 E.
3 miles E of Cotton Plant
(distance) (direction) (nearest town)

WELL PURPOSE:
(home, irrigation, municipal, industrial)

WELL COMPLETION DATA


- (1) diameter (inches) 4
- (2) total depth (feet) 550
- (3) static water level (feet) 130 below top of ground.
- (4) casing DVC 280
(material) (depth)
(size) if telescope see back.
- (5) screen _____
(length) (depth to top)
(size) (material)
- (6) pump 1 8
(HP) (yield gpm)
etc
(type power)
- (7) electric log _____
(yes or no)
(organization running log)
- (8) how well bottom plugged _____

DRILLERS REMARKS:

DEPT. OF NATURAL RESOURCES
BUREAU OF LAND & WATER RESOURCES
OCT 20 1983
RECEIVED

If well telescopes please sketch and show depths.

GROUND LEVEL

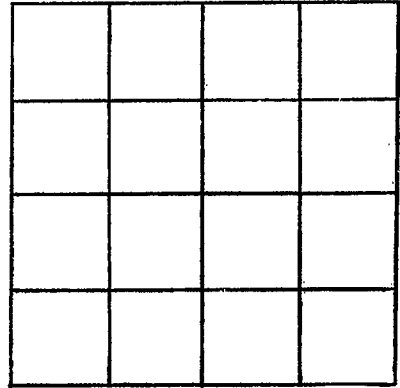

SECTION _____

Please indicate well location X.

ADDITIONAL INFORMATION

If more than one screen, show locations of each on sketch.